


Greenwood **KANSAS**

Section 10 Township 23 Range 13E

Well No. #3 Young

Company Joe Phillips et al

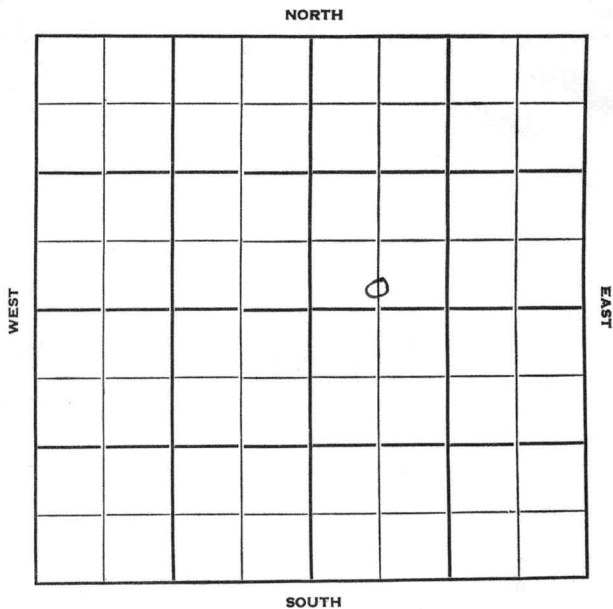

Greenwood

KANSAS

Sec. 10 Twp. 23 R. 13 E ✓

Well No. # 3 Young Farm

Joe Phillips et al Company

White & Ellis Contractor


 Ft. from N. Line

250 Ft. from S. Line

 Ft. from E. Line

600 Ft. from W. Line

C S L SW NE

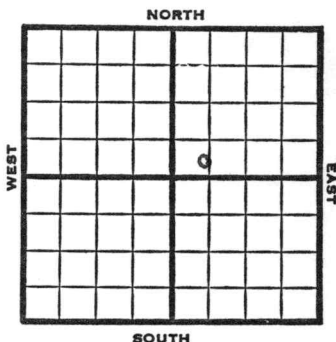

1951


REPORT

2/21 Spudded 2-17-51
8" @ 75
Drlg. 600'

3/7 Spud 2-17-51
Oil well TD 1782
8" @ 75
Miss. 1755-64
4½ " @ 1764
TD 1782 2500 A
Comp. 25 bopd

COMPLETED

County Greenwood State Kansas
 Sec. 10 (^{Blk.}23) (^{Sur.}13E) Map No. 13E
 Operator Joe Phillips et al.
 Well No. 3 Farm Young
 Elev. _____ Location C S L SW NE

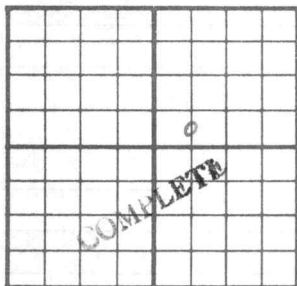

250 Ft. From S Line NE
600 Ft. From W Line Quarter

1st. Report

Completion MAR 7 1951

Remarks

White & Ellis - Contr.

Spudding Date 2-17-51

Drlg. Data Oil well TD 1782

8" @ 75 Miss. 1755-64 4½" @ 1764

TD 1782 2500 A Comp. 25 bopd

J. E. TYRA