FORM 51 10M 7-48 PETROL


KANSAS Greenwood

Section 21 Township 23 Range 9E

Well No. 5 Morris

Company Magnolia

Misc.

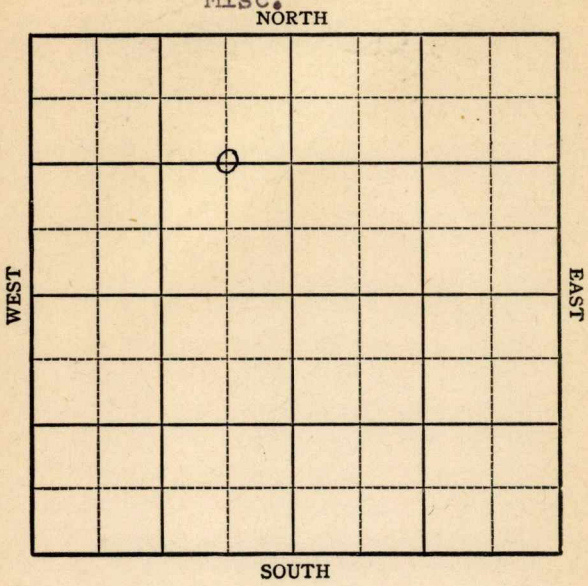

FORM 252-A
5M 4-48 PETROL

KANSAS KANSAS Greenwood

Sec. 21 Twp. 23 R. 9E

Well No. 5 Morris Farm

Magnolia Company

Miscellaneous


1340 Ft. from N. Line

Ft. from S. Line

660 Ft. from E. Line

Ft. from W. Line

C E ½ NW

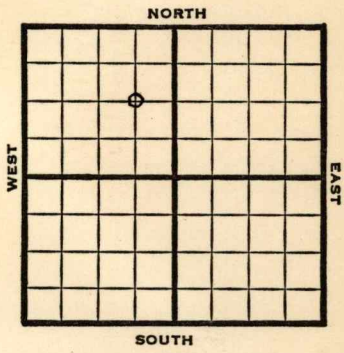

1948	E 1i REPORT
8/25	Location
9/1	"
9/8	Drlg. 1875'
9/15	Bart 2528'
	TD 2612'
	Aband.

ABANDONED

Form 27—100 Bks.—4-48—Petrol

Greenwood County Kansas State

Map No. Sec. 21 Twp. 23 R. 9E


Well No. 5 Morris

Magnolia Company

FIRST REPORT Contractor

C E ½ NW

SECTION PLAT

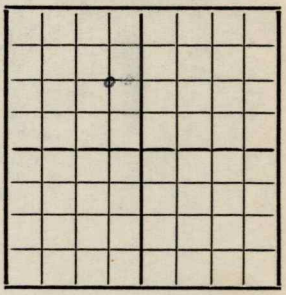

1340 Ft. from N. Line

Ft. from S. Line

660 Ft. from E. Line

Ft. from W. Line

Miscellaneous

Remarks:

Location

Date AUG 25 1948 Scout S. J. LEWIS

Form 27—100 Bks.—4-48—Petrol

Greenwood County Kansas State

Map No. 15 Sec. 21 Twp. 23 R. 9E


Well No. 5 Morris

Magnolia Company

ABANDONED Contractor

C E½ NW

SECTION PLAT

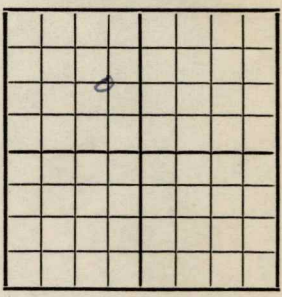

1340 Ft. from N. Line

Ft. from S. Line

660 Ft. from E. Line

Ft. from W. Line

Miscellaneous

Remarks:

Bar 2525

TJJ 2612

Date SEP 15 1948

Scout S. J. LEWIS