


KANSAS

SECTION 21 TOWNSHIP 30S RANGE 15W

WELL NO. #3 Walker "A"

COMPANY Phillips Petroleum Co.

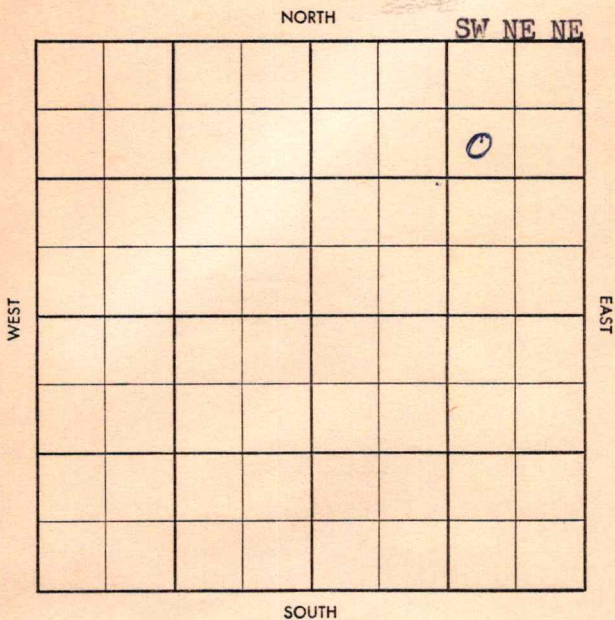

~~Top~~ Foot ~~26~~  
~~Bottom~~ Foot

S-513-B

County Barber Elev. \_\_\_\_\_  
 Sec. 21 Twp. 30 Rge. 15W  
 Company Phillips Petroleum Co.  
 Farm Name Walker "A" No. 3

TOPS	DEPTH	LOG	DATUM
Anh.			
Tp.			
H.			
Tr.			
Dg.			
B. L.			
L.			
K.C.			
B.K.C.			
Ce.			
C.			
M.			
M.			
K.			
Mz.			
Mq.			
V.			
S.			
S.			
A.			
R.			
Pf.			
G.			
T.D.			

Loc. in Sec. \_\_\_\_\_  
App SW NE NE  
 Geol. \_\_\_\_\_  
 Contr. \_\_\_\_\_  
 Pool \_\_\_\_\_  
Turkey Creek



**FIRST REPORT**  
 APR 23 1936

Date Comm. \_\_\_\_\_  
Location  
 \_\_\_\_\_  
 \_\_\_\_\_  
 \_\_\_\_\_  
 \_\_\_\_\_  
 \_\_\_\_\_  
 \_\_\_\_\_

Co. Lse. No. Sec. T. R.

Twp. ~~XXXX~~ Pool ~~XXXX~~  
 Co. ~~XXXX~~ Facet ~~XXXX~~

5-513-B

County Barber Elev. 1841 OF 1844 RB  
 Sec. 21 Twp. 30 Rge. 15W  
 Company Phillips Petroleum Co.  
 Farm Name Walker "A" No. 3

TOPS	DEPTH	LOG	DATUM
Anh.			
Tp.			
H.		3262	
Tr.		3278	
Dg.		3298	
B.L.		3924	
L.		3938	
K.C.			
B.K.C.		4344	
Ce. <i>manm</i>		4371	
C. <i>cc</i>		4452	
M.		4492	
M.			
K.			
Mz.			
Mq.		4518	
V. <i>v 0010</i>		4542	
S.			
A.			
R.			
Pf.			
G.			
T.D.	4625	4624	

Loc. in Sec. App SW NE NE  
 Geol.  
 Contr.  
 Pool Turkey Creek

0  
 COMPLETE  
 JUN 11 '58

Date Comm. 4-26-58  
 Location 8" c 869/700 MAY 7 '58  
 3525 MAY 14 '58 5" 46231 woot  
 MAY 21 '58 80/25 43-63 \$ 97.44  
 BO + tr W 8 hrs \$ 12.04 DO  
 + tr W last hr PDP MAY 28 '58  
 P 129 BO NW 24 hrs JUN 11 '58  
 Phy P 215 BO pd NW  
 VI 10 45 43-63  
 \$