


Section 26 Township 11 Range 17-W


Well No. 3 Hall "B"

Company Cities Service Oil

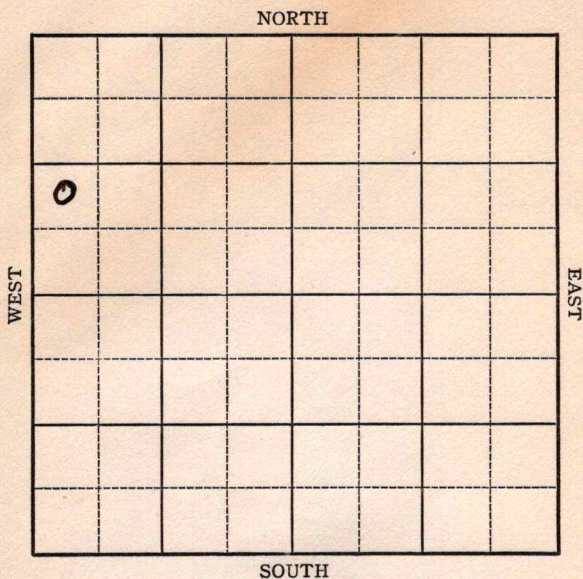

Sec. 26 Twp. 11 R. 17-WWell No. #3 Hall "B" FarmCities Service Oil Company Ft. from N. Line990 Ft. from S. Line Ft. from E. Line330 Ft. from W. Line

Elev. 1927

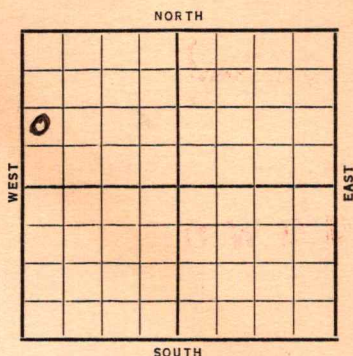

Date	REPORT
1937	
11/10	B. R. R.
11/19	R. R.
11/26	"
12/3	15" @ 106'. 10" @ 1109'. WOC.
12/10	Drlg. 2500'.
12/17	Drlg. 3360'.
12/24	Sil. 3382'. 7" @ 3383'.
	T.D. 3392'. 2950' oil.
12/31	T.D. 3400'. Pot. 3024?
1938	
1/5	7" @ 3383'.
	Arb. 3382'.
	T.D. 3400'.
	Potential 2995 bbls.
	COMPLETED
1952	
3/5	O. W. D. D Arb. 3382 7" @ 3383 OTD 3499 was arb. prod. DD Regan 3881 Granite 3923 TD 3924 Comp. for SWD

ABANDONED

Ellis

KANSAS

Map No. _____ Sec. 26 Twp. 11 R. 17WWell No. 3 Hall "B"

Cities Service Oil

Company

Contractor

FIRST REPORT

NW SW NW

____ Ft. from N. Line

990 Ft. from S. Line

____ Ft. from E. Line

330 Ft. from W. Line

SECTION PLAT

0			

Location _____

Rig up _____

Drilling and Remarks:

BRR

RECORD

Cased _____ in., _____ ft.

Sand _____

Gas _____

Oil _____

Total Depth _____

PRODUCTION

1st 24 hrs. Nat. _____

1st 24 hrs. after shot _____

Gas _____ Cu. Ft.

Dry Hole _____

Abandoned _____

Date

NOV 10 1937 19

H. D. Hatfield Scout

Ellis

KANSAS

Map No. 71 Sec. 26 Twp. 11 R. 17WWell No. 3 Hall "B"Cities Service Oil Company

Contractor

COMPLETE

NW SW NW

 Ft. from N. Line990 Ft. from S. Line Ft. from E. Line330 Ft. from W. Line**SECTION PLAT**

0			

Location Rig up

Drilling and Remarks:

RECORDCased 7 in., 3383 ft.Sand Arb 3382Gas Oil Total Depth 3400**PRODUCTION**1st 24 hrs. Nat. 1st 24 hrs. after shot Gas Cu. Ft.Dry Hole Abandoned

Date

JAN 5 - 1938 19H. D. Hatfield Scout

POT-2995

County **Ellis** State **Kansas**
 Sec. **26** (Blk. **11** (Sur. **17W** Map No.
 (Twp.) (Rge.)
 Operator **Cities Service Oil**
 Well No. **3** Farm **Hall (E)**
 Elev. **1927** Location **NW SW NW**



990 Ft. From **S** Line **NW**

330 Ft. From **W** Line Quarter

Ist. Report **MAR 5 1952**

Completion **MAR 5 1952**

Remarks **GWDD for SWD**

Spudding Date

O.W.D.D

Drlg. Data

Arb. 3382 7" @ 3383 OTD 3499 was arb prod.

DD Regan 3881 Granite 3923 TD 3924

Comp. for SWD

J. G. McGEHEE