

KANSAS

Butler

Section 9 Township 27 Range 3E

Well No. 1 Manlove

Company Inland Oil

Wildcat
NORTH

WEST

				0			

EAST

SOUTH

KANSAS

Butler



Sec. 9 Twp. 27 R. 3E

Well No. #1 Manlove Farm

Inalnd Oil

Company

Wildcat


330' Ft. from N. Line

Ft. from S. Line

Ft. from E. Line

330' Ft. from W. Line

NW NE

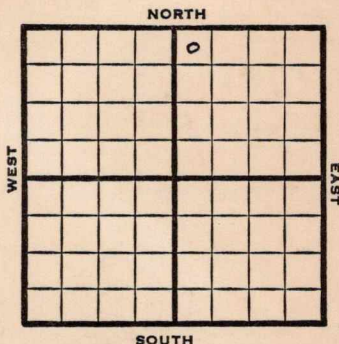

1949

Elev 1343'

REPORT

4/27

Location

5/4

Spud

5/10

8" @ 90'

5/18

Drlg 2734'

5/25

TD 3140'

Miss 2784'

Simp 3102'

Aband.

ABANDONED

Map No. _____ Sec. 9 Twp. 27 R. 3EWell No. 1 ManloveInland Oil CompanyFIRST REPORT Contractor

NW NE

SECTION PLAT

330 Ft. from N. Line Ft. from S. Line Ft. from E. Line330 Ft. from W. Line

		°	

Butler CountyLocation X

Rig up _____

Drilling and Remarks:

RECORD

Cased _____ in., _____ ft.

Sand _____

Gas _____

Oil _____

Total Depth 2050 10324

PRODUCTION

1st 24 hrs. Nat. _____

1st 24 hrs. after shot _____

Gas _____ Cu. Ft.

Dry Hole _____

Abandoned _____

Date

APR 27 1949 19S. J. LEWIS


Scout

Kansas

Wildcat

Map No. K12 Sec. 9 Twp. 27 R. 3EWell No. 1 ManloveInland Oil CompanyABANDONED Contractor

NW NE

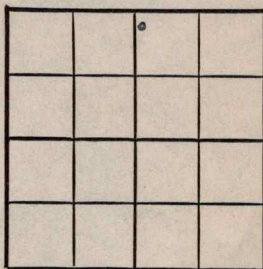E 1/4 1343
SECTION PLAT330 Ft. from N. Line Ft. from S. Line Ft. from E. Line330 Ft. from W. LineButler CountyLocation Rig up

Drilling and Remarks:

Miss 2784
Sept 3/02

RECORD

Cased in., ft.Sand Gas Oil Total Depth 3148

PRODUCTION

1st 24 hrs. Nat. 1st 24 hrs. after shot Gas Cu. Ft.Dry Hole Abandoned

Date

MAY 25 194919S. J. LEWISScout