

Well No. 4 Morris Farm
Stacey Company

N

13

四

S

Rig Up -----

Drilling Remarks:

PRODUCTION

1st 24 hrs. Nat.-----

1st 24 hrs. after shot-----

Gas ----- cu. ft.

Dry Hole -----


Abandoned -----

Map No. 115 Sec. 21 Twp. 23 R. 9Well No. 4 Moring FarmSkelly Company

Ft. from N. Line

330 Ft. from S. Line330 Ft. from E. Line

Ft from W. Line

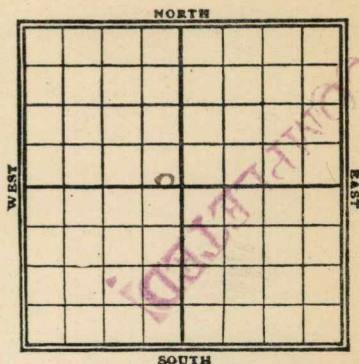

Date

REPORT **FIRST REPORT**4/23 JOH.5/1 J.O.M.7 Rig22 Rig26 Rig 7506/3 ✓ 110013 ✓ 160017 Rig ✓ 2000'23 ✓ 23007/10 243015 2518-56 49/50 Pump

Map No. K15 Sec. 21 Twp. 23 R. 9Well No. 4 MorrisShelly Company

Contractor

SECTION PLAT

Ft. from N. Line

330 Ft. from S. Line330 Ft. from E. Line

Ft. from W. Line

FIRST REPORT

Location

Rig up

Drilling and Remarks:

J.O.G.

RECORD

Cased _____ in., _____ ft.

Sand _____

Gas _____

Oil _____

Total Depth _____

PRODUCTION

1st 24 hrs. Nat. _____

1st 24 hrs. after shot _____

Gas _____ Cu. Ft.

Dry Hole _____

Abandoned _____


Date

4/231910

Pyle

Scout

State Kansas ^{R 15} County Greenwood
Sec. 21 Twp. 23 N-S; Rge. 9 E-W
Well No. 4 Morris Farm
Shelly & Boles Company

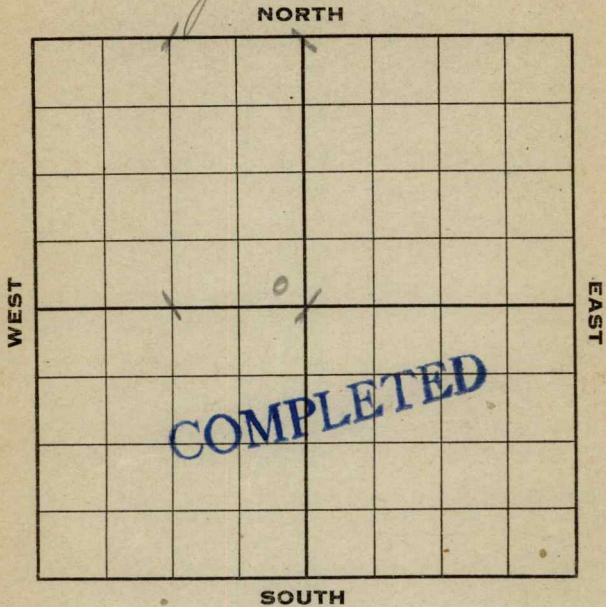

Location _____ Cased _____ in. _____ ft.
Rig up _____ Mach. _____ Productive Horizons
Drilling at _____ From _____ To _____
Fishing at _____
U. R. to _____
S. D. at _____
Natural production _____ Bbls. per _____ hours
Pumping _____ Gas _____ Cu. ft. per 24 hours
Gauge press. _____ lbs. Total depth _____
Were samples collected _____

Remarks:

Pumping 50 bbls