


Map No. K15 Sec. 21 Twp. 23 R. 9Well No. 5 Morris FarmSkelly + Boley Company

_____ Ft. from N. Line

200 Ft. from S. Line1070 Ft. from E. Line

_____ Ft. from W. Line

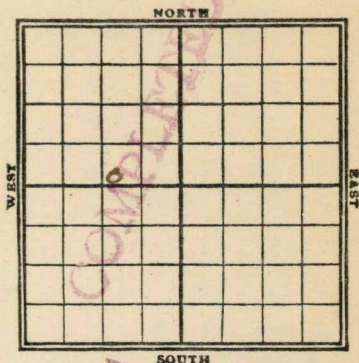

Date

REPORT

FIRST REPORT

4/23	Rig up
5/1	✓
7	✓
22	Rig
26	Log. 1400'
8/3	✓ 1700
13	65/8 @ 2470
17	SD. @ 2470'
7/10	2539-75 TD 2540
	P. B to 75'
15	2539-75 100 bbl oil
	25 - water

Map No. K15 Sec. 21 Twp. 23 R. 9Well No. 5 MorrisShelly + Boles Company

Contractor

SECTION PLAT

Ft. from N. Line

200 Ft. from S. Line1020 Ft. from E. Line

Ft. from W. Line

FIRST REPORT

Location

Rig up

Drilling and Remarks:

RECORD

Cased _____ in., _____ ft.

Sand _____

Gas _____

Oil _____

Total Depth _____

PRODUCTION

1st 24 hrs. Nat. _____

1st 24 hrs. after shot _____

Gas _____ Cu. Ft.

Dry Hole _____

Abandoned _____


Date

4/23 1920

Pyle

Scout

State Kansas County Greenwood
Sec. 21 Twp. 23 N-S; Rge. 9 E-W
Well No. 5 Morris Farm
Shelly & Bales Company

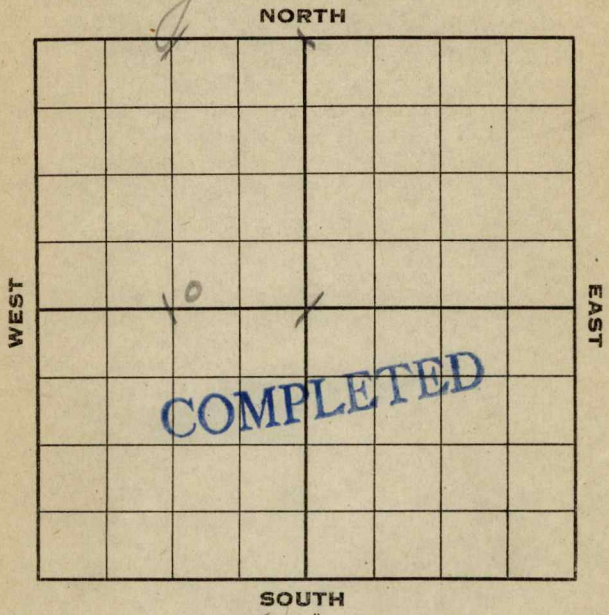

Location 2005 1020 E Cased _____ in. _____ ft.
Rig up _____ Mach. _____ Productive Horizons
From _____ To _____
Drilling at _____
Fishing at _____ 2539-2575
U. R. to _____
S. D. at _____
Natural production _____ Bbls. per _____ hours
Pumping _____ Gas _____ Cu. ft. per 24 hours
Gauge press. _____ lbs. Total depth 2590
Were samples collected _____

Remarks:
100 bbls Oil
25 bbls Water
7/15 20 Pyle Scout
S. C. 9-1M-11-19. 29023 (Over)