


Section 11 Township 23 Range 13-E

Well No. #2 John Luthi "A"

Company Payrock Oil

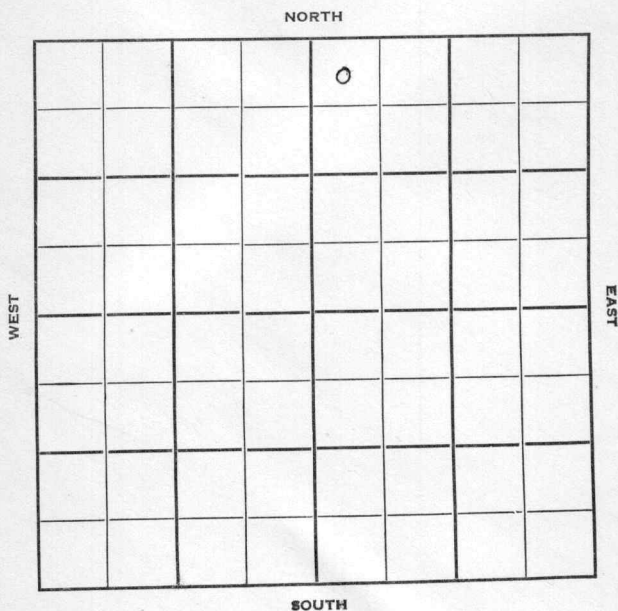

11

Sec. _____ Twp. _____ R. _____

Well No. #2 John Luthi "A" Farm

Payrock Oil Company

White & Ellis -Contr. Contractor


330' Ft. from N. Line

_____ Ft. from S. Line

_____ Ft. from E. Line

330' Ft. from W. Line

NW NW NE

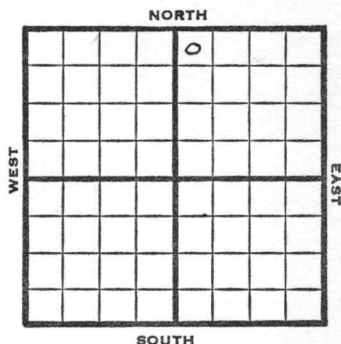

1950

?

REPORT

10/11

Spud 10-1-50

8" @ 15'

Miss 1771'

TD 1795'

4" @ 1793'

11/15

8" @ 15'

Miss 1771'

TD 1795'

4" @ 1793'

DD 1807


2000 A

Comp 10 bopd

TD 1807

Completed

COMPLETED

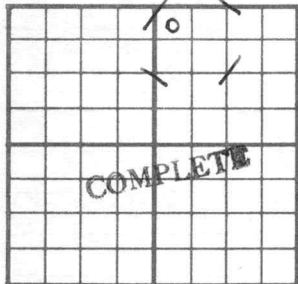County Coffey State KansasSec. 11 (Blk. Twp.) 23 (Sur. Rge.) 13E Map No. _____Operator Payrock OilWell No. 2 Farm John Luthi "A"Elev. _____ Location NW NW NE330 Ft. From N Line NE330 Ft. From W Line Quarter

1st. Report _____

Completion NOV 15 1950

Remarks _____

White & Ellis - Contr.Spudding Date 10-1-50Drlg. Data Oilwell TD 18078" @ 15 Miss. 1771 TD 1795 4" @ 1793DD 1807 2000 A Comp. 10 bopd

County Coffey State KansasSec. 11 (Blk. 23) (Sur. 13E) Map No.Operator Payrock OilWell No. 2 Farm John Luthi "A"Elev. Location NW NW NE

330 Ft. From N Line NE330 Ft. From W Line Quarter1st. Report OCT 11 1950

Completion

Remarks

White & Ellis - Contr.Spudding Date 10-1-50

Drlg. Data

8" @ 15 Miss. 1771 TD 1795 4" @ 1793

J. E. TYRA