


N

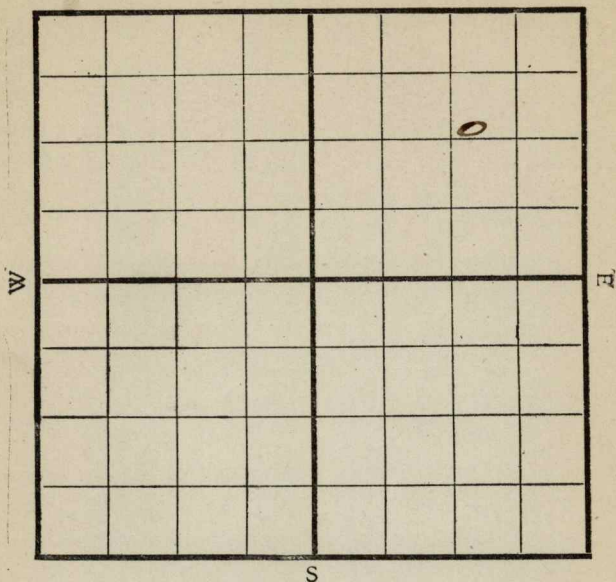

Rig Up

Drilling Remarks:

PRODUCTION


1st 24 hrs. Nat.-----

1st 24 hrs. after shot-----

Gas ----- cu. ft.

Dry Hole -----

Total Depth_____

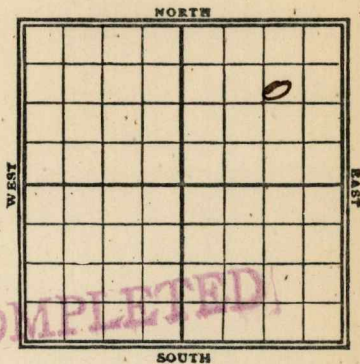Map No. R Sec. 21 Twp. 23 R. 9Well No. 2 Peter Farm
Minnehoma Co Company990 Ft. from N. Line Ft. from S. Line990 Ft. from E. Line Ft. from W. Line

Date

REPORT

FIRST REPORT

6/10	Rig up.
13	✓
17	✓
23	Wdy 700
7/10	1620
15	Fry tools 2140
20	✓
28	Wdy @ 2250
8/13	6 3/8 @ 2378'
8/21	8-10 @ 2378'
9/21	2352-75 gms - 2423-39
	oil - ID 2345.
	20 lbs - 6 m gas

Map No. K15 Sec. 21 Twp. 23 R. 9Well No. 2 Teter
Minnehoma Oil Company

Contractor

SECTION PLAT

			0

990 Ft. from N. Line

Ft. from S. Line

990 Ft. from E. Line

Ft. from W. Line

FIRST REPORT

Location

Rig up ☒

Drilling and Remarks:

RECORD

Cased _____ in., _____ ft.

Sand _____

Gas _____

Oil _____

Total Depth _____

PRODUCTION

1st 24 hrs. Nat. _____

1st 24 hrs. after shot _____

Gas _____ Cu. Ft.

Dry Hole _____

Abandoned _____

Date

5/20 1920

Pyle

Scout

Map No. K 15 Sec. 21 Twp. 23 R. 9Well No. 2 Peter
Minnehoma Oil Company

Contractor _____

SECTION PLAT

990 Ft. from N. Line

_____ Ft. from S. Line

990 Ft. from E. Line

_____ Ft. from W. Line

			10

COMPLETED

Location _____

Rig up _____

Drilling and Remarks:

RECORD

Cased _____ in., _____ ft.

Sand _____

Gas 2352-78Oil 2423-39Total Depth 2345

PRODUCTION

1st 24 hrs. Nat. 20 bbls

1st 24 hrs. after shot _____

Gas 6,000,000 Cu. Ft.

Dry Hole _____

Abandoned _____

Date

8/27 1920

Pyle

Scout