

Map No. BUTLER KANSAS Sec. 18 Twp. 25<sup>S</sup> R. 4<sup>E</sup>

Well No. 2 - Joseph Farm

Claw et al Company

NORTH

WEST

EAST

|  |   |  |  |  |  |  |  |
|--|---|--|--|--|--|--|--|
|  |   |  |  |  |  |  |  |
|  |   |  |  |  |  |  |  |
|  | 0 |  |  |  |  |  |  |

SOUTH

Location.....

Drilling Remarks

.....

.....

RECORD

Cased..... in..... ft.

Sand.....

Gas.....

Oil.....

Total Depth.....

Rig Up.....

Drilling Remarks

.....

.....

PRODUCTION

1st 24 hrs. Nat.....

1st 24 hrs. after shot.....

Gas..... cu. ft.....

Dry Hole.....

Abandoned.....

Map No. .... Sec. .... Twp. .... R. ....

Well No. .... Farm


..... Company

..... Ft. from N. Line

..... Ft. from S. Line

..... Ft. from E. Line

..... Ft. from W. Line

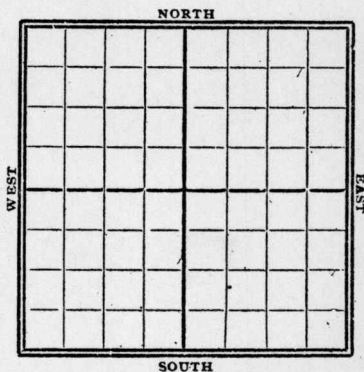

1928

Date

REPORT

*Gypsy Records*

5/26

*Abd T.D. 666'*

MAP NO. K19 KANSAS SEC. 18 TWP. 25S R. 4E

WELL NO. 2 Joseph

3 fan et al COMPANY

CONTRACTOR

### SECTION PLAT

**ABANDONED**

\_\_\_\_\_ FT. FROM N. LINE

\_\_\_\_\_ FT. FROM S. LINE

\_\_\_\_\_ FT. FROM E. LINE

\_\_\_\_\_ FT. FROM W. LINE

|  |  |  |  |
|--|--|--|--|
|  |  |  |  |
|  |  |  |  |
|  |  |  |  |
|  |  |  |  |

LOCATION \_\_\_\_\_

RIG UP \_\_\_\_\_

DRILLING AND REMARKS:

### RECORD

CASED \_\_\_\_\_ IN. \_\_\_\_\_ FT.

SAND \_\_\_\_\_

GAS \_\_\_\_\_

OIL \_\_\_\_\_

TOTAL DEPTH 666

### PRODUCTION

1ST 24 HRS. NAT. \_\_\_\_\_

1ST 24 HRS. AFTER SHOT \_\_\_\_\_

GAS \_\_\_\_\_ CU. FT.

DRY HOLE ☒

ABANDONED ☒

DATE

8/26 192 8 SCOUT