

Section 20 Township 25 Range 4 EWell No. # 2 MillerCompany Wixson

						0	

NORTH

WEST

EAST

SOUTH

Butler		KANSAS
SEC.	TWP.	R.
20	25	4 E ✓
WELL NO.		
# 2 Miller		FARM
COMPANY		
Wixson		
CONTRACTOR		

Potwin Pool


330 Ft. from N. Line

Ft. from S. Line

990 Ft. from E. Line

Ft. from W. Line

NW NE NE

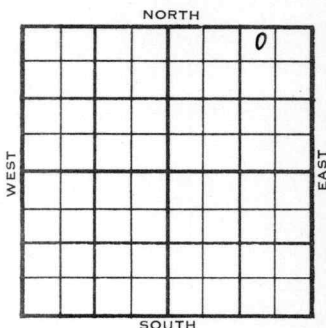

	ELEVATION	REPORT
1954	1310'	
3/31	MICT	
5/12	Spud 4-2-54 Oil Well TD 2549' 15" @ 140' 13" @ 778' 10" @ 1682' KC 2085' 8" @ 2170' Miss 2526' 7" @ 2528' TD 2549' Sd-frac Comp. 25 bopd	
COMPLETED		

County Butler State Kansas

Sec. 20 (Blk. Twp.) 25 (Sur. Rge.) 4E Map No.

Operator Wixson

Well No. 2 Farm Miller

Elev.	1310	Location	NW NE NE
-------	------	----------	----------

[illegible]

330 Ft. From N Line NE

990 Ft. From E Line Quarter

1st. Report

Completion

Remarks	Potwin Pool
---------	-------------

Spudding Date 4-2-54

Drilg. Data Oil well TD 2549

15" @ 140 13" @ 778 10" @ 1682

KC 2085 8" @ 2170 Miss. 2526

7" @ 2528 TD 2549 sd-frac

Comp. 25 bopd

J. G. McGEHEE