


Section 17 Township 27 Range 3 E

Well No. # 1 Scott

Company J. P. Gaty

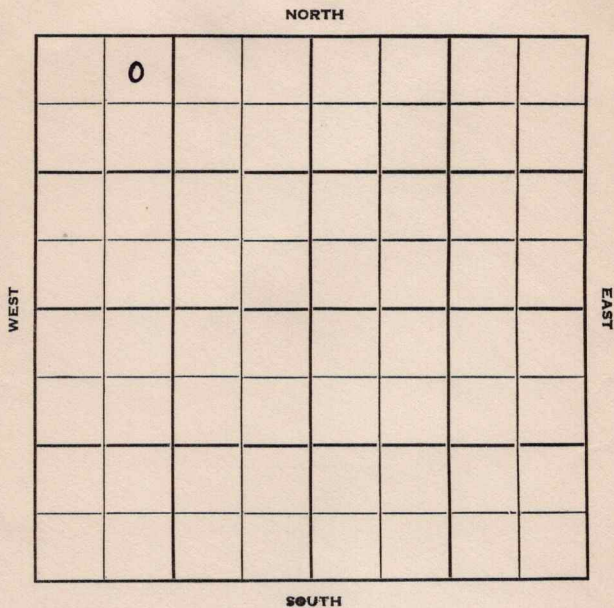

Butler

KANSAS

3E

Sec. 17 Twp. 27 R. ☒

Well No. #1 Scott Farm

J. P. Gaty Company

Howell - Contr. Contractor


330' Ft. from N. Line

Ft. from S. Line

Ft. from E. Line

990' Ft. from W. Line

NE NW NW

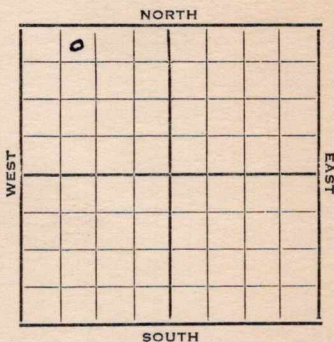

1951 Elev. 1354' REPORT

12/19 Spud 12-15-51
15" @ 110
Drlg. 245'

1952
2/6 Fishing

2/13 "

2/20 Spud 12-15-51
D&A TD 2569
15" @ 110 10" @ 772'
8" @ 1915 7" @ 2293
KC 2360 TD 2569
D&A

ABANDONED

County **Butler** State **Kansas**Sec. **17** (Blk. Twp.) **27** (Sur. Rge.) **3E** Map No.Operator **J. P. Gaty**Well No. **1** Farm **Scott**Elev. Location **NE NW NW**

330 Ft. From **N** Line **NW****990** Ft. From **W** Line Quarter1st. Report **DEC 1 9 1951**

Completion

Remarks

Howell - Contr.Spudding Date **12-15-51**Drlg. Data **Wildcat****15" @ 110 Drlg. 245****J. E. TYRA**

County Butler State Kansas
 Sec. 17 (Blk. 27 (Sur. 3E Map No.
 Operator J. P. Gatty
 Well No. 1 Farm Scott
 Elev. 1354 Location NE NW NW

0						

330 Ft. From N Line NW
990 Ft. From W Line Quarter
 1st. Report
 Completion FEB 20 1952
 Remarks Wildcat
Howell - Contr.
 Spudding Date 12-15-51

Drlg. Data D & A TD 2569
15" @ 110 10" @ 772 8" @ 1915
7" @ 2293 Kc 2360 TD 2569
D & A

J. G. McGEHEE