


Map No. KANSAS Sec. 21 Twp. 25 R. 4Well No. 1-Albers Farm
Sage-Fowler et al Company

NORTH

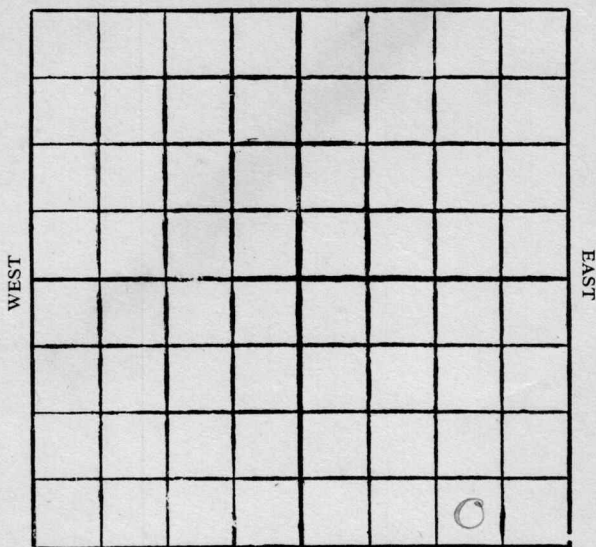

SOUTH

Location

Drilling Remarks

Rig Up

Drilling Remarks

RECORD

Cased in. ft.

Sand

Gas

Oil

Total Depth

PRODUCTION

1st 24 hrs. Nat.

1st 24 hrs. after shot

Gas cu. ft.

Dry Hole

Abandoned


Map No. KANSAS Sec. 21 Twp. 25 R. 4E
 Well No. 1 - Albers Farm
Sage Fowler et al Company

_____ Ft. from N. Line

330 Ft. from S. Line

990 Ft. from E. Line

_____ Ft. from W. Line

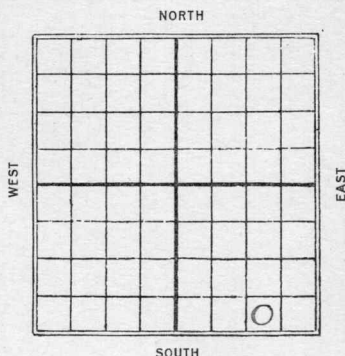

1928

Date

REPORT

Date	REPORT
3/15	Bldg Rig
3/22	Rig
3/29	Drilg 1315
4/5	" 1810
4/12	" 2100
4/19	Chot 2553-2630 T.D.
	Swab 90 bbls 1st 24 hrs May shoot
4/26	2553-2630 T.D. 2630
	40/60 bbls

14 KANSAS 21 25 4
Map No. Sec. Twp. R.

Well No. 1 albers

Sage-Jeweler et al Company

Contractor

FIRST REPORTS

SECTION PLAT

			o

Ft. from N. Line

330 Ft. from S. Line

990 Ft. from E. Line

Ft. from W. Line

Location

Rig up

Drilling and Remarks:

RECORD

Cased in., ft.

Sand

Gas

Oil

Total Depth

PRODUCTION

1st 24 hrs. Nat.

1st 24 hrs. after shot

Gas Cu. Ft.

Dry Hole

Abandoned

Date

MAR 15 1928 CHAS. L. SHERWOOD Scout

Map No. 14 KANSAS Sec. 21 Twp. 25 R. 4^E

Well No. 1 Albers
Sage - Jewell & Co Company

Contractor

COMPLETED

SECTION PLAT

_____ Ft. from N. Line

330 Ft. from S. Line

990 Ft. from E. Line

_____ Ft. from W. Line

Location _____

Rig up _____

Drilling and Remarks:

407 60 Bls.

RECORD

Cased _____ in., _____ ft.

Sand 7553-7630

Gas _____

Oil _____

Total Depth 7630

PRODUCTION

1st 24 hrs. Nat. _____

1st 24 hrs. after shot _____

Gas _____ Cu. Ft.

Dry Hole _____

Abandoned _____

Date

APR 23 1928

192

CHAS. L. SHERWOOD

Scout