FORM 51 10M 2-49 PETROL

KANSAS


Butler

Section 6 Township 25 Range 4-E

Well No. #1 Jacobs

Company Cox etal

Miscellaneous

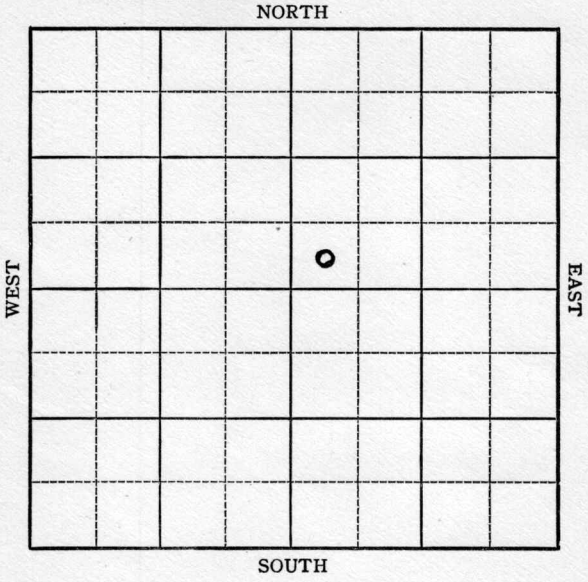

FORM 252-A
5M 10-48 PETROL

KANSAS Butler ✓

Sec. 6 Twp. 25 R. 4E

Well No. 1 Jacobs Farm

Cox et al Company

Misc.

Contr. Gore & Burns


_____ Ft. from N. Line

330 Ft. from S. Line

_____ Ft. from E. Line

330 Ft. from W. Line

SW NE

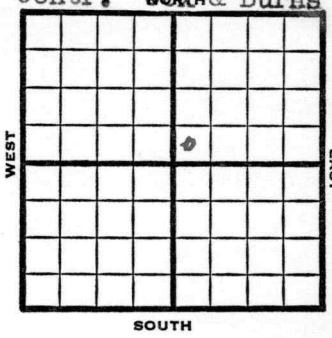

1949	Elev 1328' REPORT
8/24	15" @ 68' 13" @ 855' Drlg. 1165'
8/31	10"@ 1668' Drlg 1820'
9/7	8" @ 2110' KC 2240' Drlg. 2580'
9/14	6"@ 2610 CO
9/21	Miss 2695' TD 2700' 5" @ 2697'
9/28	TD 2730' Miss 2695' 5"@ 2697' 1000 acid Pump 20 Oil Pot 38° Gr. Comp COMPLETED

Form 26 200 Bks. 6-49 Petrol

Miscellaneous

Kansas

Map No. _____ Sec. 6 Twp. 25 R. 4E

Well No. 1 Jacobs


Cox etal. Company

Cox & Burns Contractor

SW NE

FIRST REPORT

SECTION PLAT

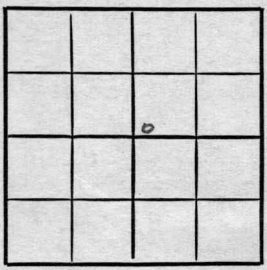

_____ Ft. from N. Line

330 Ft. from S. Line

_____ Ft. from E. Line

330 Ft. from W. Line

Butler County

Location

Rig up

Drilling and Remarks:

15" @ 68

13" @ 855

drlg. 1165

RECORD

Cased _____ in., _____ ft.

Sand

Gas

Oil

Total Depth

PRODUCTION

1st 24 hrs. Nat.

1st 24 hrs. after shot

Gas _____ Cu. Ft.

Dry Hole

Abandoned

Date

AUG 24 1949 19 S. J. LEWIS Scout

Form 26 200 Bks. 6-49 Petrol

Miscellaneous

Kansas

Map No. _____ Sec. 6 Twp. 25 R. 4E

Well No. 1 Jacobs


Cox etal. Company

COMPLETE Contractor

SW NE

E 1,328.

SECTION PLAT

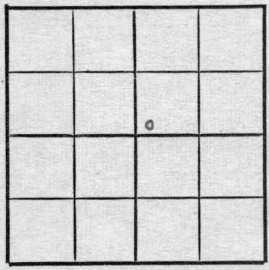

_____ Ft. from N. Line

330 Ft. from S. Line

_____ Ft. from E. Line

330 Ft. from W. Line

Butler County

Location _____

Rig up _____

Drilling and Remarks:

Miss 2695.

5" @ 2697

1000 acid

Pump 20 oil BH

85% Gr

RECORD

Cased _____ in., _____ ft.

Sand _____

Gas _____

Oil _____

Total Depth 2730

PRODUCTION

1st 24 hrs. Nat. _____

1st 24 hrs. after shot _____

Gas _____ Cu. Ft.

Dry Hole _____

Abandoned _____

Date

SEP 28 1949 19

S. J. LEWIS Scout