


LOCATION NOTICE

TULSA, OKLA., July 29, 1952WELL NO. 1 ON Floyd Seltzer FARM

WILL BE AS FOLLOWS:

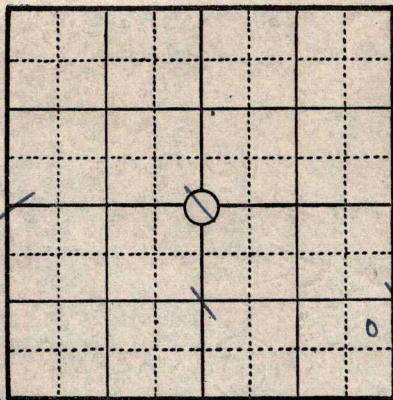

..... FEET FROM NORTH LINE

330

..... FEET FROM EAST LINE

990

..... FEET FROM SOUTH LINE

..... FEET FROM WEST LINE

SW/4 & S/2 SE/4IN..... SEC. 8 TWP. 35S RANGE 3WSumner COUNTY, STATE OF KansasREMARKS: R. L. Mankey - Dist. Supt.A. E. Johnson - Dist. ForemanMCPC - 100%Well #1 - NE/4 SE/4 SE/4SIGNED A. E. Pierce

COPIES TO

R. W. McDOWELL
 DISTRICT SUPT.
 ACCOUNTING DEPT.
 SCOUTING DEPT. ✓
 GEOLOGICAL DEPT.
 PIPE LINE DEPT.
 MATERIALS DEPT.
 RENTAL DEPT.
 LEGAL DEPT.
 LEO MEYER
 INCOME TAX DEPT.
 ENGINEERING DEPT.
 LEASE INVENTORY
 CLAIM DEPT.
 J. W. BASORE
 FILE

*Card signed
mm*