


Section 21 Township 25 Range 4-E

Well No. 1 Albers

Company Smith & Polhamus

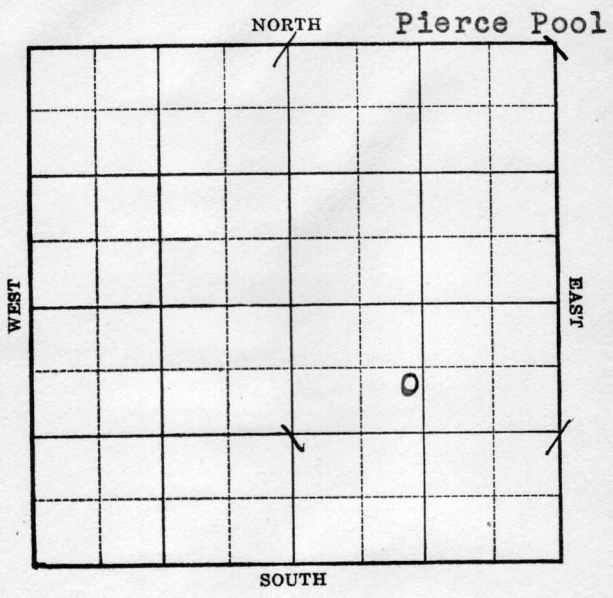

Sec. 21 Twp. 25 R. 4-E

Well No. #1 Albers Farm \_\_\_\_\_

Smith & Polhamus Company \_\_\_\_\_


(Pierce)

820 Ft. from N. Line

\_\_\_\_\_ Ft. from S. Line

\_\_\_\_\_ Ft. from E. Line

1145 Ft. from W. Line

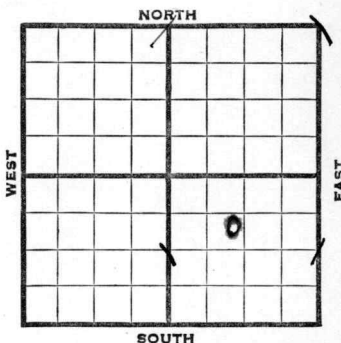

1939	REPORT
3/22	15" - 98'
	Drlg. 702'
3/31	12" - 1185' Drlg. 1235'
4/7	10" - 1557' T.D. 1600' C. O.
4/14	10" - 1650' Drlg. 2100'
4/21	6" - 2293' Drlg. 2400'
4/28	K. C. 2105' Miss. 2541'
	5" - 2541' T.D. 2588'
	200' oil & S. W. in 10 hours.
5/5	" " " " " "
5/12	" " " " " "
5/19	Shut down.
5/26	" "
6/1	" "
6/8	" "
6/14	Miss. 2541'
	T.D. 2759' H.F.W. 2757'
	ABANDONED

Butler **KANSAS**

Map No. 14 Sec. 21 Twp. 25 R. 4E

Well No. 1 Albers

Smith & Polhamus Company

Contractor

**FIRST REPORT**

SE NW SE

820 Ft. from N. Line


\_\_\_\_\_ Ft. from S. Line

\_\_\_\_\_ Ft. from E. Line

1145 Ft. from W. Line

**PIERCE POOL**

**SECTION PLAT**

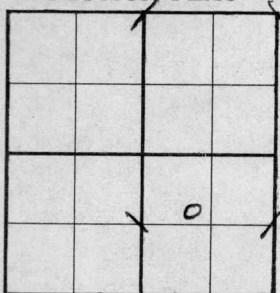

Location \_\_\_\_\_

Rig up \_\_\_\_\_

Drilling and Remarks:

15" - 98

Drlg. 702

**RECORD**

Cased \_\_\_\_\_ in., \_\_\_\_\_ ft.

Sand \_\_\_\_\_

Gas \_\_\_\_\_

Oil \_\_\_\_\_

Total Depth \_\_\_\_\_

**PRODUCTION**

1st 24 hrs. Nat. \_\_\_\_\_

1st 24 hrs. after shot \_\_\_\_\_

Gas \_\_\_\_\_ Cu. Ft.

Dry Hole \_\_\_\_\_

Abandoned \_\_\_\_\_

Date

MAR 22 1939

19

H. D. Hatfield Scout

Map No. 14 Sec. 21 Twp. 25 R. 4E

Well No. 1 Albers

Smith & Polhamus Company

Contractor

ABANDONED  
SE NW SE


820 Ft. from N. Line

\_\_\_\_\_ Ft. from S. Line

\_\_\_\_\_ Ft. from E. Line

1145 Ft. from W. Line

SECTION PLAT

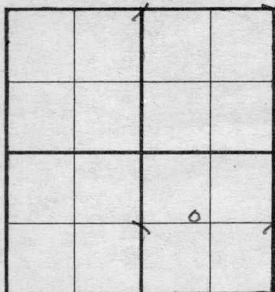

PIERCE POOL

Location \_\_\_\_\_

Rig up \_\_\_\_\_

Drilling and Remarks:

*Miss 2541*  
*NFW 2757*

RECORD

Cased \_\_\_\_\_ in., \_\_\_\_\_ ft.

Sand \_\_\_\_\_

Gas \_\_\_\_\_

Oil \_\_\_\_\_

Total Depth 2759

PRODUCTION

1st 24 hrs. Nat. \_\_\_\_\_

1st 24 hrs. after shot \_\_\_\_\_

Gas \_\_\_\_\_ Cu. Ft.

Dry Hole \_\_\_\_\_

Abandoned \_\_\_\_\_

Date

JUN 14 1939

19

S. J. LEWIS

Scout