
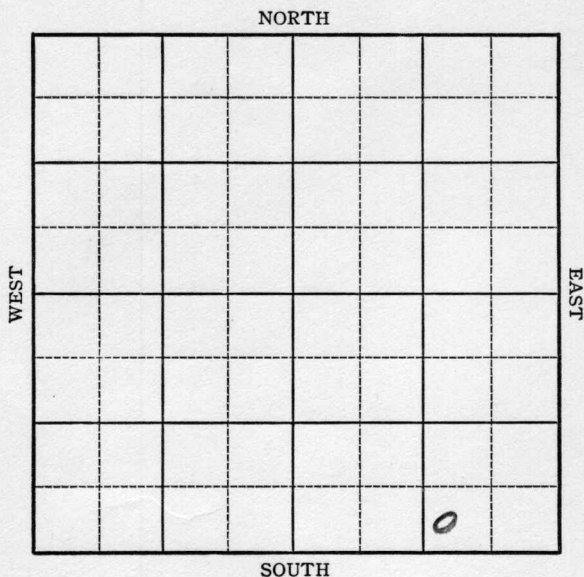


Section 21 Township 25 Range 4-E

Well No. #1 Albers

Company Polhamus

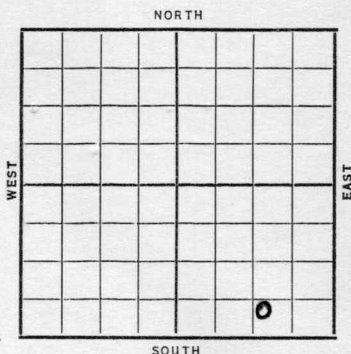

Sec. 21 Twp. 25 R. 4-EWell No. #1 Albers FarmPolhamus Company Ft. from N. Line550 Ft. from S. Line1250 Ft. from E. Line Ft. from W. Line

Date	REPORT
1937	
10/27	12" @ 128'.
	10" @ 805'.
	Drlg. 1220'.
11/5	8" @ 1490' T.D. C.O.
11/12	T.D. 2000'. U. R. 8".
11/19	8" @ 1890'. K.C. 2135'.
	Drlg. 2225'.
11/26	6" @ 2275'. C.O.
12/3	" " " "
12/10	Miss. 2547'.
	Fsg. liner 2548' T.D.
12/17	" " " "
12/24	" " " "
12/31	S.O. 2559'. T.D. 2574'.
	700' oil. 5" @ 2534'.
1938	
1/7	" " " "
1/14	" " " "
1/20	" " " "
1/28	TD 2600' Testing.
2/4	" " " "

OVER

1938

2/11 T.D. 2600'.
Testing.

2/18 " "

2/26 " "

3/4 " "

3/11 " "

3/18 " "

3/25 T.D. 2600' SD.

3/30 5" @ 2534'.

Miss. 2547'.

T.D. 2600'.

10 oil & 20 wtr.

COMPLETED

Butler

KANSAS

Map No. 14 Sec. 21 Twp. 25 R. 4EWell No. 1 AlbersPolhamus

Company

Contractor

FIRST REPORT

SW SE SE

Ft. from N. Line

550

Ft. from S. Line

1250 Ft. from E. Line

Ft. from W. Line

SECTION PLAT

			o

Location _____

Rig up _____

Drilling and Remarks:

12" - 12810" - 805Drlg-1220

RECORD

Cased _____ in., _____ ft.

Sand _____

Gas _____

Oil _____

Total Depth _____

PRODUCTION

1st 24 hrs. Nat. _____

1st 24 hrs. after shot _____

Gas _____ Cu. Ft.

Dry Hole _____

Abandoned _____

Date

OCT 27 1937

19

H. D. Hatfield

Scout

Butler KANSAS

Map No. 14 Sec. 21 Twp. 25 R. 4EWell No. 1 AlbersPolhamus

Company

Contractor

COMPLETED**SW SE SE** Ft. from N. Line550 Ft. from S. Line1250 Ft. from E. Line Ft. from W. Line**SECTION PLAT**

			0

Location Rig up

Drilling and Remarks:

10 oil
20 wtr

RECORDCased 5 in., 2534 ft.Sand MISS 2547Gas Oil Total Depth 2600**PRODUCTION**1st 24 hrs. Nat. 1st 24 hrs. after shot Gas Cu. Ft.Dry Hole Abandoned

Date

MAR 30 1938

19

H. D. Hatfield

Scout