


Map No. _____ Sec. 10 Twp. 23 R. 13
 Well No. 15 Schneider Farm _____
Theta Company _____

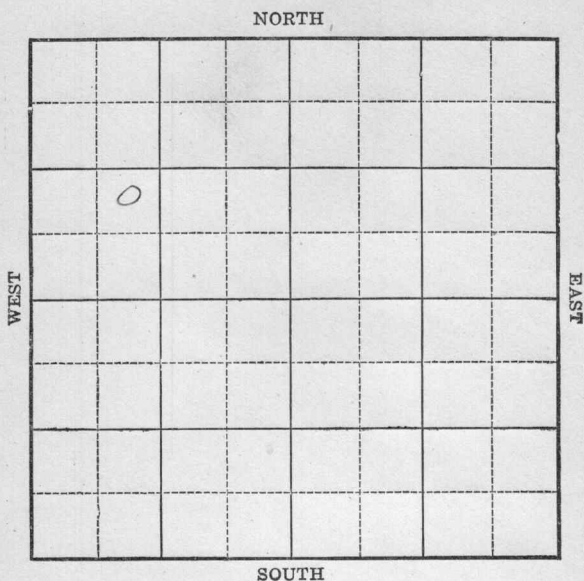

Location _____

Drilling Remarks:

Rig up _____

Drilling Remarks:

RECORD

Cased _____ in. _____ ft.

Sand _____

Gas _____

Oil _____

Total Depth _____

PRODUCTION

1st 24 hrs Nat. _____

1st 24 hrs. after shot _____


Gas _____ cu. ft.

Dry Hole _____

Abandoned _____

Map No. _____ Sec. 10 Twp. 23 R. 13
Well No. 15 Schneider Farm _____
Theta Company _____

_____ Ft. from N. Line
1120 Ft. from S. Line
_____ Ft. from E. Line
760 Ft. from W. Line

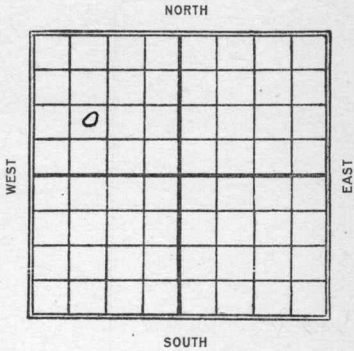

Date	REPORT
1923	
7/16	Location.
8/4	Rig
8/15	Sand 1585-1648-Shot
	809 to 10 Bbls. Oil.
	100 Bbls. water.

Map No. **KANSAS** 17 10 Sec. 10 Twp. 23 R. 13

Well No. 15 Schneider

Thula Company

Contractor

FIRST REPORT

Ft. from N. Line

1120 Ft. from S. Line

Ft. from E. Line

760 Ft. from W. Line

SECTION PLAT

o			

Location ✓ ✓

Rig up

Drilling and Remarks:

RECORD

Cased _____ in., _____ ft.

Sand _____

Gas _____

Oil _____

Total Depth _____

PRODUCTION

1st 24 hrs. Nat. _____

1st 24 hrs. after shot _____

Gas _____ Cu. Ft.

Dry Hole _____

Abandoned _____

Date

JUL 16 1923

M. A. BENEAR

192

Scout

KANSAS

Map No. _____ Sec. 10 Twp. 23 R. 13Well No. 15 SchneiderTheta Company

Contractor

COMPLETED SECTION PLAT

_____ Ft. from N. Line

1120 Ft. from S. Line

_____ Ft. from E. Line

760 Ft. from W. Line

0			

Location _____

Rig up _____

Drilling and Remarks:

sand { 1585
164880/10 flb oil100 flb water

RECORD

Cased _____ in., _____ ft.

Sand _____

Gas _____

Oil _____

Total Depth _____

PRODUCTION

1st 24 hrs. Nat. _____

1st 24 hrs. after shot _____

Gas _____ Cu. Ft.

Dry Hole _____

Abandoned _____

Date

AUG 15 1923

M. A. BENEAR

192

Scout