

Sec.

Twp.

R.

Well No.

Farm

Company

NORTH

WEST

EAST

SOUTH

FIRST REPORT

Location _____

Rig Up_____

Drilling Remarks:

Drilling Remarks:

RECORD

PRODUCTION

Cased _____ in. _____ ft.

1st 24 hrs. Nat._____

Sand _____

1st 24 hrs. after shot_____

Gas _____

Gas_____cu. ft.

Oil _____

Dry Hole _____

Total Depth _____

Abandoned _____

Map No. _____ Sec. 10 Twp. 23 R. 13


Well No. 9 Schneider Farm
Theta Company

Ft. from N. Line

200 Ft. from S. Line

Ft. from E. Line

200 Ft. from W. Line

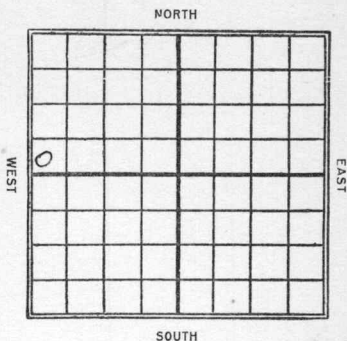

Date _____

Date
1922

10/26

1923

 $\frac{1}{6}$

REPORT

Spurd.

Pay sand 1777-91 - Shot
60 gts. 15 Bbs.

Map No. 17 **KANSAS** Sec. 10 Twp. 23 R. 13

Well No. 9 *Schneider*
T. Heta Company

Contractor

COMPLETED SECTION PLAT

_____ Ft. from N. Line

200 _____ Ft. from S. Line

_____ Ft. from E. Line

200 _____ Ft. from W. Line

0			

RECORD

Location _____

Rig up _____

Drilling and Remarks:

Tap line 1770
pay 1777-91'
shot 60 gts
15 lbs.

Cased _____ in., _____ ft.

Sand _____

Gas _____

Oil _____

Total Depth _____

PRODUCTION

1st 24 hrs. Nat. _____

1st 24 hrs. after shot _____

Gas _____ Cu. Ft.

Dry Hole _____

Abandoned _____

Date

JAN 6 1923

M. A. BENEAR

191

Scout

Map No. **KANSAS** ¹⁷ Sec. ¹⁰ Twp. ²³ R. ¹³Well No. ⁹ *Schneider**J. L. Leta* Company

Contractor

FIRST REPORT

SECTION PLAT

Ft. from N. Line

200 Ft. from S. Line

Ft. from E. Line

200 Ft. from W. Line

RECORD

Location

Cased _____ in., _____ ft.

Rig up

Sand

Drilling and Remarks:

Gas

Oil

Total Depth

PRODUCTION

1st 24 hrs. Nat.

1st 24 hrs. after shot

Gas _____ Cu. Ft.

Dry Hole

Abandoned

Date

OCT 26 1922

M. A. BENEAR

191

Scout