KANSAS


FORM 51 5M 6-46 PETROL

Butler county

Section 7 Township 25 Range 4-E

Well No. #1, Ellis

Company Cox and Burns

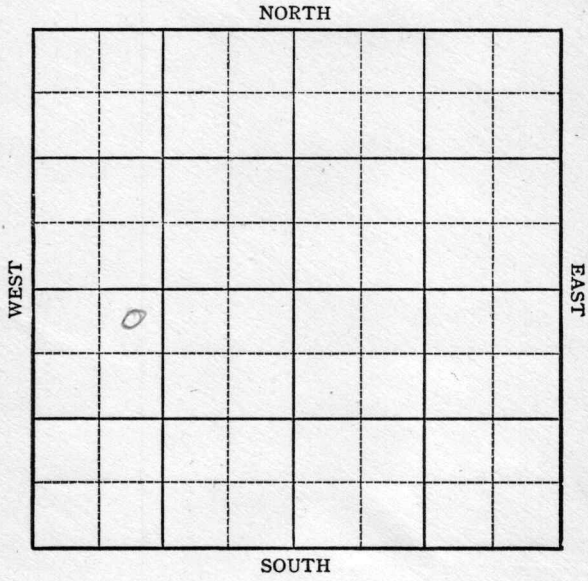

FORM 252-A
5M 6-46 PETROL

KANSAS

Butler

Sec. 7 Twp. 25 R. 4E

Well No. 1 Ellis Farm

Cox & Burns Company

Miscellaneous


330 Ft. from N. Line

Ft. from S. Line

Ft. from E. Line

990 Ft. from W. Line

NE NW SW

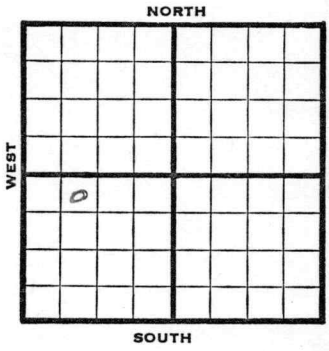

1946	REPORT
11/20	2575' Fishing
11/27	" "
12/4	Miss 2694' TD 2750'
	ABANDONED

Form 26 200 Bks. 10-46 Petrol Kansas

KANSAS Miscellaneous

Map No. 14 Sec. 7 Twp. 25 R. 4E

Well No. 1 Ellis

Cox & Burns Company

FIRST REPORT

Contractor

NE NW SW


330 Ft. from N. Line

Ft. from S. Line

Ft. from E. Line

990 Ft. from W. Line

SECTION PLAT

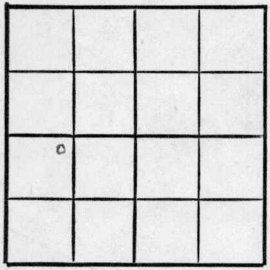

Butler County

Location

Rig up

Drilling and Remarks:

2575 fishing

RECORD

Cased in., ft.

Sand

Gas

Oil

Total Depth

PRODUCTION

1st 24 hrs. Nat.

1st 24 hrs. after shot

Gas Cu. Ft.

Dry Hole

Abandoned

Date

NOV 20 1946

19 S. J. LEWIS Scout

Form 26 200 Bks. 10-46 Petrol KANSAS Miscellaneous
Kansas

Map No. 14 Sec. 7 Twp. 25 R. 4E

Well No. 1 Ellis

Cox & Burns Company

ABANDONED Contractor

NE NW SW

330 Ft. from N. Line


____ Ft. from S. Line

____ Ft. from E. Line

990 Ft. from W. Line

Butler County

SECTION PLAT

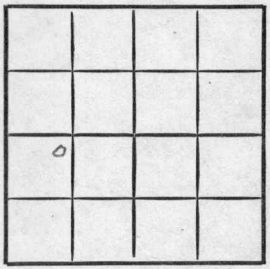

Location

Rig up

Drilling and Remarks:

Mis2684

RECORD

Cased ____ in., ____ ft.

Sand

Gas

Oil

Total Depth 2250

PRODUCTION

1st 24 hrs. Nat.

1st 24 hrs. after shot

Gas ____ Cu. Ft.

Dry Hole

Abandoned

Date

DEC 4 1946

19 S. J. LEWIS Scout