


Map No. 1-7 Sec. 7 Twp. 25 R. 46
 Well No. Ellis Farm
Palmer Company

NORTH

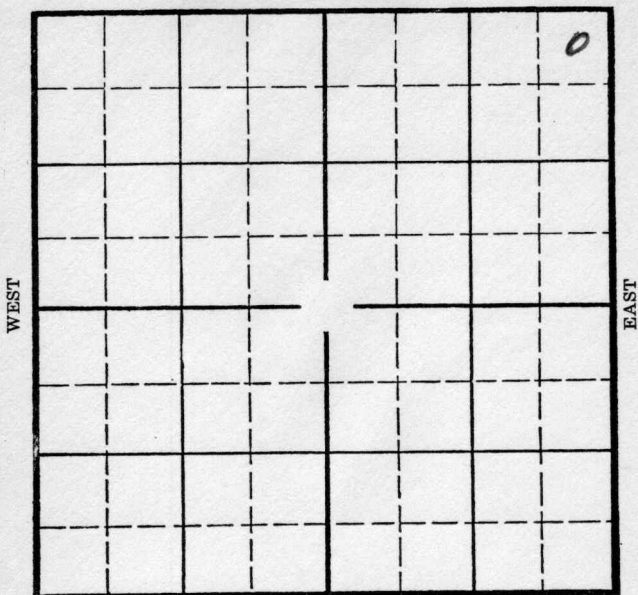

SOUTH

Location _____
 Drilling Remarks _____

Rig Up _____
 Drilling Remarks _____

RECORD

Cased _____ in. _____ ft.
 Sand _____
 Gas _____
 Oil _____
 Total Depth _____

PRODUCTION

1st 24 hrs. Nat. _____
 1st 24 hrs. after shot _____
 Gas _____ cu. ft. _____
 Dry Hole _____
 Abandoned _____

KANSAS


Map No. _____ Sec. 7 Twp. 25 R. 4E

Well No. 1- Ellis Farm _____

Palmer

Company _____

NORTH

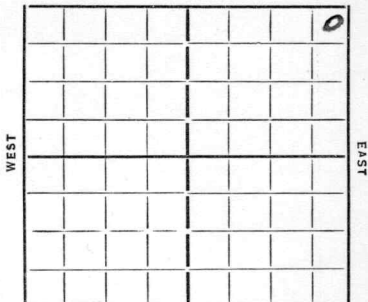

SOUTH

330

Ft. from N. Line

Ft. from S. Line

330

Ft. from E. Line

Ft. from W. Line

Elev. 1338

Date 1935

REPORT

9/4

Location

10/3

alg 1675

10/10

" 2265

10/30

TML 2703

TD 2751

D. & A.

ABANDONED

Map No. 14 Sec. 7 Twp. 25 R. 4EWell No. 1-EllisPalmer Company

Contractor

SECTION PLAT

			0

330 Ft. from N. Line

Ft. from S. Line

330 Ft. from E. Line

Ft. from W. Line

Location ☒

Rig up

Drilling and Remarks:

RECORD

Cased.....in.,ft.

Sand.....

Gas.....

Oil.....

Total Depth.....

PRODUCTION

1st 24 hrs. Nat.....

1st 24 hrs. after shot.....

Gas.....Cu. Ft.

Dry Hole.....

Abandoned.....

Date

ORVAL MANNSCHRECK

9-4-35 192

Scout

KANSAS

Form 26 - 1M Bks. - 9-28

Map No. 14 Sec. 7 Twp. 25 R. 4EWell No. 1-EllisPalmer

Company

Contractor

ABANDONED

SECTION PLAT

			0

330 Ft. from N. Line

Ft. from S. Line

330 Ft. from E. Line

Ft. from W. Line

RECORD

Location

Cased in, ft.

Rig up

Sand TML 2703

Drilling and Remarks:

Gas

Oil

Total Depth 2751NOT A

PRODUCTION

1st 24 hrs. Nat.

1st 24 hrs. after shot

Gas Cu. Ft.

Dry Hole

Abandoned

Date

10-30-35 192 Scout

ORVAL MANNSCHECK