


Map No. K Sec. 10 Twp. 23 R. 13
Well No. 18 - Schnader Farm
Theta Company

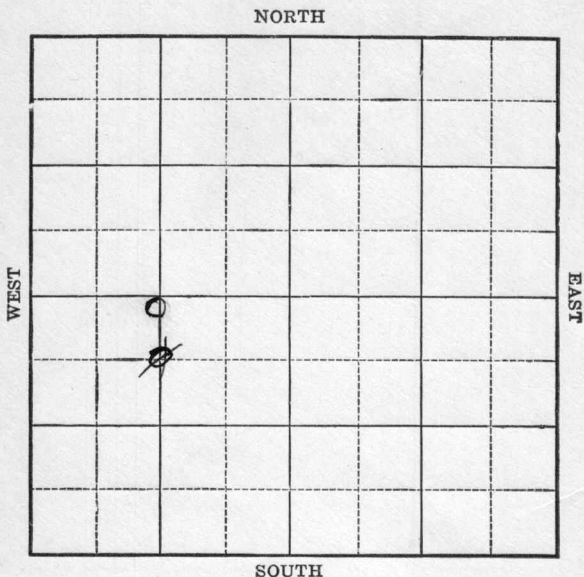

Location _____

Drilling Remarks:

Rig Up _____

Drilling Remarks:

RECORD

Cased _____ in. _____ ft.

Sand _____

Gas _____

Oil _____

Total Depth _____

PRODUCTION

1st 24 hrs. Nat. _____

1st 24 hrs. after shot _____

Gas _____ cu. ft.

Dry Hole _____

Abandoned _____

Map No. 75 Sec. 10 Twp. 23 R. 13Well No. 18 Schneider FarmTheta

Company

200
660


Ft. from N. Line

Ft. from S. Line

Ft. from E. Line

1320

Ft. from W. Line

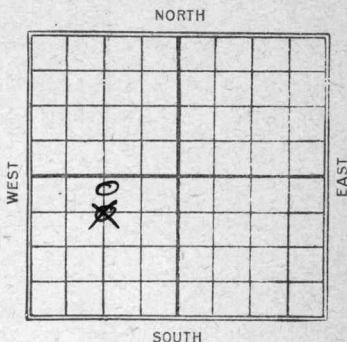Date 1924

REPORT

4/2 Imbes.19245/22 Top Line. 1762Pay 1766-89.40725 Bbl

Map No. **KANSAS** Sec. 10 Twp. 23 R. 13

Well No. 18—Schneider

Thia Company

Contractor

COMPLETED SECTION PLAT

200 Ft. from N. Line

_____ Ft. from S. Line

_____ Ft. from E. Line

1320 Ft. from W. Line

Location _____

Rig up _____

Drilling and Remarks:

Tap 1762
Pay 1766-89
40/25

RECORD

Cased _____ in., _____ ft.

Sand _____

Gas _____

Oil _____

Total Depth _____

PRODUCTION

1st 24 hrs. Nat. _____

1st 24 hrs. after shot _____

Gas _____ Cu. Ft

Dry Hole _____

Abandoned _____

Date

MAY 22 1924

M. A. BENEAR

192

S

Map No. KANSAS 17 Sec. 10 Twp. 23 R. 13
 Well No. 18 - schneider
Thetis Company

Contractor

FIRST REPORT

SECTION PLAT

660 Ft. from N. Line

_____ Ft. from S. Line

_____ Ft. from E. Line

1320 Ft. from W. Line

Location _____

Rig up _____

Drilling and Remarks:

Thickers

RECORD

Cased _____ in., _____ ft.

Sand _____

Gas _____

Oil _____

Total Depth _____

PRODUCTION

1st 24 hrs. Nat. _____

1st 24 hrs. after shot _____

Gas _____ Cu. Ft.

Dry Hole _____

Abandoned _____

Date

APR 2 1924

M. A. BENEAR

192

Scout