

Butler
 Map No. KANSAS Sec. 12 Twp. 25^S R. 4^E
 Well No. 1- W. H. Shumaker (Farm)
R. E. O. Frazie Company

NORTH

WEST

							0

EAST

SOUTH

Location.....

Rig Up.....

Drilling Remarks

Drilling Remarks

RECORD

Cased.....in.....ft.

Sand.....

Gas.....

Oil.....

Total Depth.....

PRODUCTION

1st 24 hrs. Nat.....

1st 24 hrs. after shot.....

Gas.....cu. ft.....

Dry Hole.....

Abandoned.....

Map No. Sec. Twp. R.

Well No. Farm


..... Company

..... Ft. from N. Line

..... Ft. from S. Line

..... Ft. from E. Line

..... Ft. from W. Line

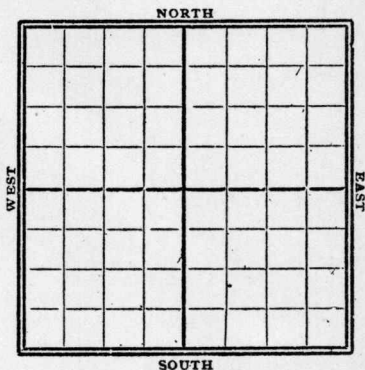

1915

Date

REPORT

Gypsy Records

10/18

Abd T.D. 750

Bentley
 K14 KANSAS SEC. *12* TWP. *25S* R. *VE*
 MAP NO. _____
 WELL NO. *1 H. H. Schumacher*
R. E. Drayner COMPANY

CONTRACTOR

SECTION PLAT

ABANDONED

_____ FT. FROM N. LINE
 _____ FT. FROM S. LINE
 _____ FT. FROM E. LINE
 _____ FT. FROM W. LINE

RECORD

LOCATION _____
 RIG UP _____
 DRILLING AND REMARKS: *✓*

CASED _____ IN., _____ FT.
 SAND _____
 GAS _____
 OIL _____
 TOTAL DEPTH *750*

PRODUCTION

1ST 24 HRS. NAT. _____
 1ST 24 HRS. AFTER SHOT _____
 GAS _____ Cu. Ft. *✓*
 DRY HOLE _____
 ABANDONED *✓*

DATE

12-18-15 192 _____ SCOUT