


Well No. 2 Letter Farm

Nazlett & Davis Company

NORTH

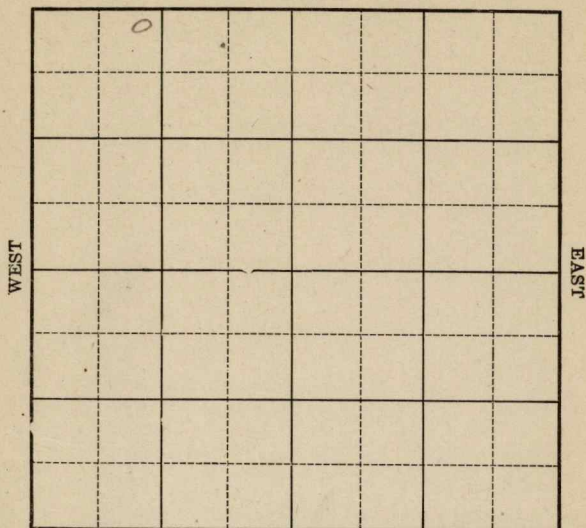

SOUTH

Location _____

Drilling Remarks

Rig Up

Drilling Remarks

RECORD

Cased _____ in. _____ ft.

Sand

Gas _____

Oil

Total Depth

PRODUCTION

1st 24 hrs. Nat. _____

1st 24 hrs. after shot -----

Gas_____cu. ft.

Dry Hole

Abandoned _____


Form 252A—5M—7-25—19684
Map No. Sec. 22 Twp. 23 R 9
Well No. 2 Teter Farm
Haylett & Davis Company

9330 Ft. from N. Line

Ft. from S. Line

Ft. from E. Line

990 Ft. from W. Line

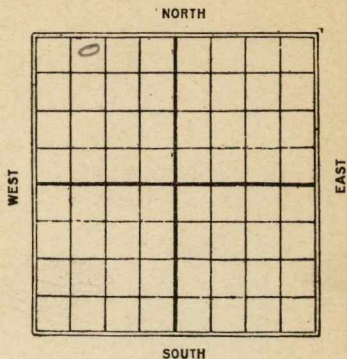

Date _____

REPORT

Date	REPORT
1925	
12/23	Bldg Rig
12/31	Rig
1926	
1/8	Spudding.
1/14	—
1/30	Drill 200'
1/27	✓ 1040'
2/4	✓ 1420'
2/10	✓ 1800'
2/17	—
2/3	Sand 2330-2398 180 gts 20 Bbls

Map No. **KANSAS** ¹⁵ Sec. **22** Twp. **23** R. **9**

Well No. **2** **Leton**
Hazlett & Davis Company

Contractor

SECTION PLAT

330 Ft. from N. Line

Ft. from S. Line

Ft. from E. Line

990 Ft. from W. Line

o			

FIRST REPORTS

Location

Rig up

Drilling and Remarks:

Blow Rev

RECORD

Cased in., ft.

Sand

Gas

Oil

Total Depth

PRODUCTION

1st 24 hrs. Nat.

1st 24 hrs. after shot

Gas Cu. Ft.

Dry Hole

Abandoned

Date

DEC 23 1925

192

CHAS. L. SHERWOOD

Scout

H. Sherwood &
K15 KANSAS 22 23 9
Map No. Sec. Twp. R.
Well No. 2 2e 6n
43 600 2 Davis Company

Contractor

COMPLETED

SECTION PLAT

330 Ft. from N. Line
Ft. from S. Line
Ft. from E. Line
990 Ft. from W. Line

0			

Location
Rig up
Drilling and Remarks:

oil 2347-88
180y 20 88.

RECORD

Cased in., ft.
Sand 2330-2398
Gas
Oil
Total Depth 2398

PRODUCTION

1st 24 hrs. Nat.
1st 24 hrs. after shot
Gas Cu. Ft.
Dry Hole
Abandoned

Date

MAR 3 1926 CHAS. L. SHERWOOD
192 Scout