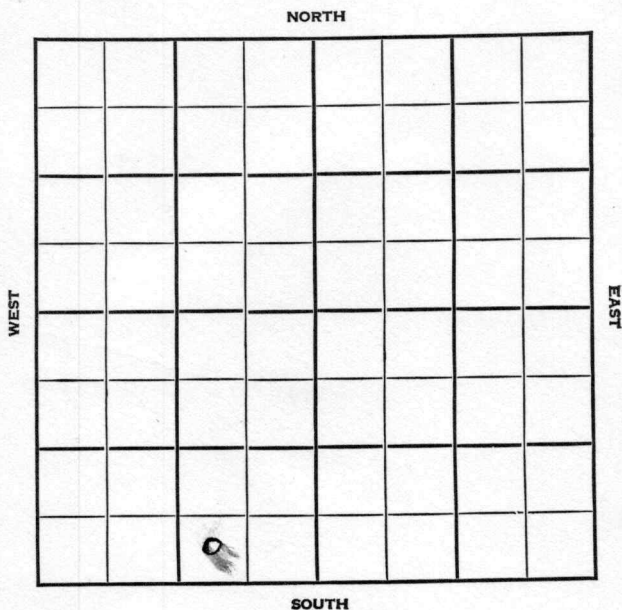


Section 13 Township 25 Range 4EWell No. #2 BanksCompany Ralph Wixson

KANSAS Butler

Sec. 13 Twp. 25 R. 4E

Well No. #2 Banks Farm

Ralph Wixson Company

Miscellaneous


Ft. from N. Line

330' Ft. from S. Line

990' Ft. from E. Line

Ft. from W. Line

SW SE SW

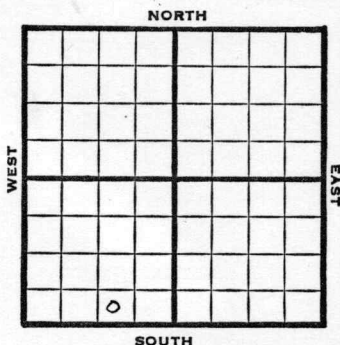

1948

Eli 1403'

REPORT

6/9

Location

6/16

15" @ 225'

Drlg. 240'

6/23

Drlg 275'

6/29

12"@ 888

10"@ 1696'

Drlg 1765'

7/14

TD 2626'

Miss 2611'

7"@ 2611'

Pump 25 Oil Pot

38° Gr.

Comp.

COMPLETED

Map No. _____ Sec. 13 Twp. 25 R. 4E


Well No. 2 Banks

Ralph Wixson Company

FIRST REMEDY Contractor

SW SE SW

SECTION PLAT

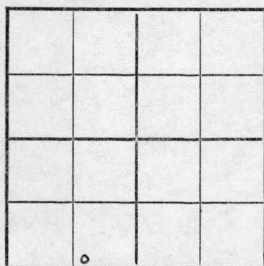

_____ Ft. from N. Line

330 Ft. from S. Line

990 Ft. from E. Line

_____ Ft. from W. Line

Butler County

Location X

Rig up _____

Drilling and Remarks:

RECORD

Cased _____ in., _____ ft.

Sand _____

Gas _____

Oil _____

Total Depth _____

PRODUCTION

1st 24 hrs. Nat. _____

1st 24 hrs. after shot _____

Gas _____ Cu. Ft.

Dry Hole _____

Abandoned _____

Date

JUN 9 1948 19 _____ S. J. LEWIS _____ Scout


Map No. 14 Sec. 13 Twp. 25 R. 4EWell No. 2 BanksRalph Wixson

Company

COMPLETE

Contractor

SW SE SW

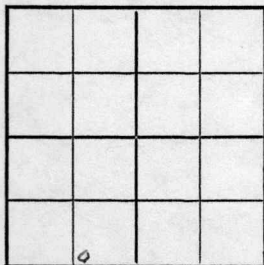E 1/403
SECTION PLAT Ft. from N. Line330 Ft. from S. Line990 Ft. from E. Line Ft. from W. Line

Butler County

Location Rig up

Drilling and Remarks:

Miss 26117" @ 2611Prod 25 oil BT080/32

RECORD

Cased in., ft.Sand Gas Oil Total Depth 2626

PRODUCTION

1st 24 hrs. Nat. 1st 24 hrs. after shot Gas Cu. Ft.Dry Hole Abandoned

Date

JUL 14 1948

19

S. J. LEWIS

Scout