


Map No. K Sec. 10 Twp. 23 R. 13Well No. 19 - Schneider FarmTheta Oil Company

NORTH

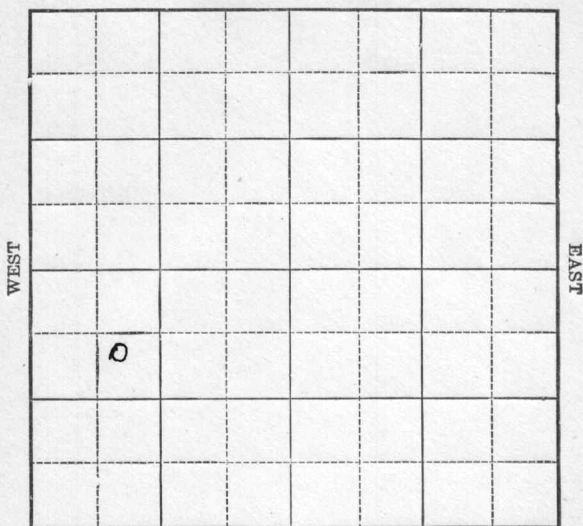

SOUTH

Location _____

Drilling Remarks:

Rig Up _____

Drilling Remarks:

RECORD

Cased _____ in. _____ ft.

Sand _____

Gas _____

Oil _____

Total Depth _____

PRODUCTION

1st 24 hrs. Nat. _____

1st 24 hrs. after shot _____


Gas _____ cu. ft.

Dry Hole _____

Abandoned _____

Map No. K Sec. 10 Twp 23 R. 13
Well No. 19 Schneider Farm
Theta Oil Company

760 Ft. from N. Line
 Ft. from S. Line
 Ft. from E. Line
760 Ft. from W. Line

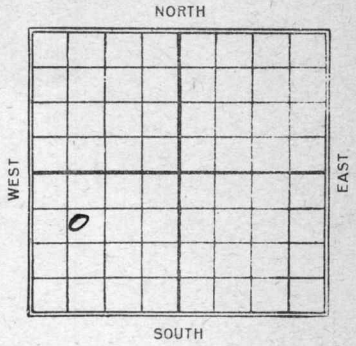

Date	REPORT
1924	
4/21	Lumbus.
7/16	fish 1700'
10/8	Pay 1828-33 T.D. 1844'
	50 gts 5 Bbls

Map No. KANSAS 17 Sec. 10 Twp. 23 R. 13

Well No. 19 — Schneider
Thetis Oil Company

Contractor

FIRST REPORT

SECTION PLAT

760 Ft. from N. Line

_____ Ft. from S. Line

_____ Ft. from E. Line

760 Ft. from W. Line

0			

Location _____

Rig up _____

Drilling and Remarks:

Timbers

RECORD

Cased _____ in., _____ ft.

Sand _____

Gas _____

Oil _____

Total Depth _____

PRODUCTION

1st 24 hrs. Nat. _____

1st 24 hrs. after shot _____

Gas _____ Cu. Ft.

Dry Hole _____

Abandoned _____

Date

APR 21 1924

M. A. BENEAR

192

Scout

KANSAS
 Map No. _____ Sec. 10 Twp. 23 R. 13

Well No. 19 Schneider
Thuta Oil Company

Contractor _____

COMPLETED SECTION PLAT

760 Ft. from N. Line

_____ Ft. from S. Line

_____ Ft. from E. Line

760 Ft. from W. Line

0			

Location _____

Rig up _____

Drilling and Remarks:

Pay 1828-33
JD. 1844
50/5 Hb

RECORD

Cased _____ in., _____ ft.

Sand _____

Gas _____

Oil _____

Total Depth _____

PRODUCTION

1st 24 hrs. Nat. _____

1st 24 hrs. after shot _____

Gas _____ Cu. Ft.

Dry Hole _____

Abandoned _____

Date

OCT 8 1924

M. A. BENEAR

192

Scout