

Well No. 20 Schurder Farm

Company

NORTH

WEST

EAST

SOUTH

Location _____

Drilling Remarks

Rig Up-----

Drilling Remarks

RECORD

Cased _____ in. _____ ft.

Sand

Gas

Oil

Total Depth_____

PRODUCTION

1st 24 hrs. Nat.-----

1st. 24 hrs. after shot-----

Gas-----cu. ft.

Dry Hole

Abandoned _____

Map No. Kansas Sec. 10 Twp. 23 R. 13


Well No. 20 Schnurder Farm
Theta Company

_____ Ft. from N. Line

1120 Ft. from S. Line

200 Ft. from E. Line

_____ Ft. from W. Line

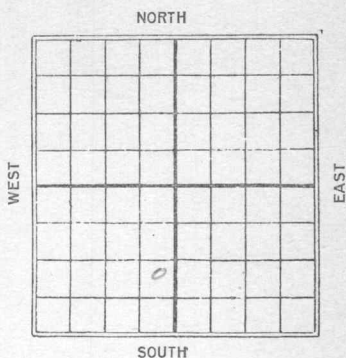

Date

REPORT

1925

3/1

Sly 200

3/30

1485-1805 60 gals 20 Bbls

Map No. 11113 Sec. 10 Twp. 23 R. 13

Well No. 20 Schneider

T. H. H. H. Company

Contractor

FIRST REPORT

_____ Ft. from N. Line

1120 Ft. from S. Line

200 Ft. from E. Line

_____ Ft. from W. Line

SECTION PLAT

	0		

Location _____

Rig up _____

Drilling and Remarks:

10 lg. 200

RECORD

Cased _____ in., _____ ft.

Sand _____

Gas _____

Oil _____

Total Depth _____

PRODUCTION

1st 24 hrs. Nat. _____

1st 24 hrs. after shot _____

Gas _____ Cu. Ft.

Dry Hole _____

Abandoned _____

Date

3/1 1925

M. A. BENEAR Scout

17 KANSAS Map No. Sec. 10 Twp. 23 R. 13

Well No. 20 Schneider

Theta oil Company

Contractor

COMPLETED

SECTION PLAT

_____Ft. from N. Line

1120 Ft. from S. Line

200 Ft. from E. Line

_____Ft. from W. Line

	9		

Location _____

Rig up _____

Drilling and Remarks:

shot 60 qt.

RECORD

Cased _____ in., _____ ft.

Sand 1785-1805

Gas _____

Oil _____

Total Depth 1805

PRODUCTION

1st 24 hrs. Nat. _____

1st 24 hrs. after shot 20

Gas _____ Cu. Ft.

Dry Hole _____

Abandoned _____

Date

3/30 1925

M. A. BENEAR

Scout