


Section 2 Township 28 Range 8 E


Well No 2 E. C. Edgar "A"

Company K. T. Weidemann

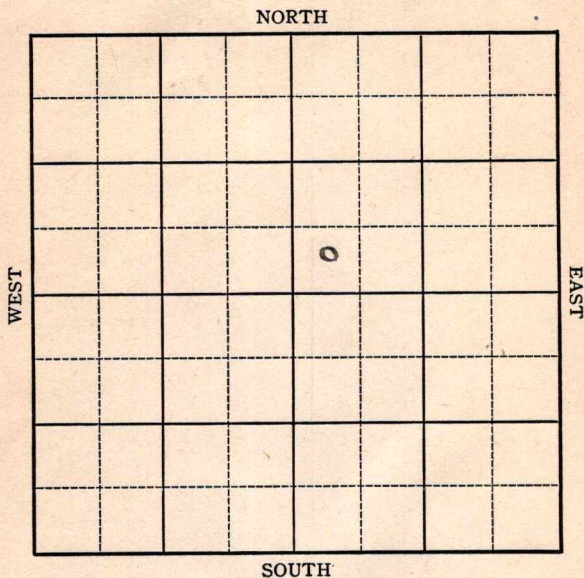

Sec. 2 Twp. 28 R. 8-EWell No. #2 E. C. Edgar "A" FarmK. T. Weidemann Company

NORTH

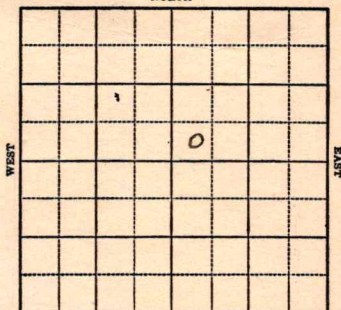

SOUTH

 Ft. from N. Line330 Ft. from S. Line Ft. from E. Line455 Ft. from W. Line

1943

R E P O R T

11/17 Cellar

11/24 Mach

12/1 Spud 50'

12/8 Drlg. 750'

12-15 SD

12/22 12" @ 925
10" @ 1110
Drlg. 1210'

12/29 1230 Run 8"

1944

1-5 8" @ 1230
Drlg 1252'

1-12 Drlg 2160'

1/19 Fsg. 2160'

1/26 " "

2/2 7" @ 2162
CO2/8 Miss 2467
5" @ 2465TD 2488 $\frac{1}{2}$ -1100' oil in 12 hrs.

OVER

1944
2/16

5" @ 2465

Miss 2467

TD 2488 $\frac{1}{2}$

2000 acid

Pump 25 pot

Gravity 38.1

COMPLETED

KANSAS

Map No. 10 Sec. 2 Twp. 28 R. 8EWell No. 2 E. C. Edgar "A"K. T. Weidemann CompanyFIRST REPORT Contractor

SW NE

SECTION PLAT

		o	

 Ft. from N. Line330 Ft. from S. Line Ft. from E. Line455 Ft. from W. LineMiscellaneousLocation Rig up

Drilling and Remarks:

Cellar

RECORD

Cased in., ft.Sand Gas Oil Total Depth

PRODUCTION

1st 24 hrs. Nat. 1st 24 hrs. after shot Gas Cu. Ft.Dry Hole Abandoned

Date

NOV 17 1943 19S. J. LEWIS Scout

KANSASMap No. 10 Sec. 2 Twp. 28 R. 8EWell No. 2 E. C. Edgar "A"K. T. Weidemann Company**COMPLETED**

Contractor

SW NE**SECTION PLAT**

		10	

 Ft. from N. Line330 Ft. from S. Line Ft. from E. Line455 Ft. from W. Line**Miscellaneous**Location Rig up

Drilling and Remarks:

*Miss 2467**5" @ 2465.**2000 acid**Pump 25 Pst**25 1/2 Gr***RECORD**Cased in., ft.Sand Gas Oil Total Depth 2488 1/2**PRODUCTION**1st 24 hrs. Nat. 1st 24 hrs. after shot Gas Cu. Ft.Dry Hole Abandoned

Date

FEB 16 1944 19S. J. LEWIS Scout