

Map No. **KANSAS** Sec. **13** Twp. **25** R. **4**

Well No. **1 - Carlisle** Farm
Walsh & Effaw Company

NORTH

(Carlisle)

WEST

EAST

SOUTH

Location

Drilling Remarks

Rig Up

Drilling Remarks

RECORD

Cased..... in. ft.

Sand

Gas

Oil

Total Depth.....

PRODUCTION

1st 24 hrs. Nat.

1st 24 hrs. after shot.....

Gas..... cu. ft.

Dry Hole.....

Abandoned


KANSAS
Map No. _____ Sec. 13 Twp. 25 R. 4
Well No. 1 - Garlile Farm
walsh & Effaw Company

_____ Ft. from N. Line

200 Ft. from S. Line

200 Ft. from E. Line

_____ Ft. from W. Line

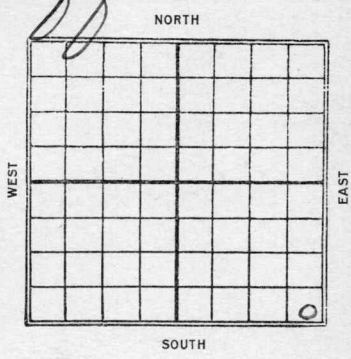

1928

Date

REPORT

524 H.F.W. 780'

Butlers

14 KANSAS
Map No. _____ Sec. *13* Twp. *25* R. *4*

Well No. *1*
Walsh & Egan

Company _____

Contractor _____

~~FIRST REPORTS~~

COMPLETED

SECTION PLAT

_____ Ft. from N. Line

700 Ft. from S. Line

700 Ft. from E. Line

_____ Ft. from W. Line

			o

Location _____

Rig up _____

Drilling and Remarks:

AFW 780

RECORD

Cased _____ in., _____ ft.

Sand _____

Gas _____

Oil _____

Total Depth *800*

PRODUCTION

1st 24 hrs. Nat. _____

1st 24 hrs. after shot _____

Gas _____ Cu. Ft.

Dry Hole *✓*

Abandoned _____

Date

MAY 24 1928

CHAS. L. SHERWOOD

192

Scout

Butler
K14 KANSAS MAP NO. SEC. 13 TWP. 25S R. 4E

WELL NO. _____

Walsh - Egan COMPANY

CONTRACTOR _____

SECTION PLAT

ABANDONED

_____ FT. FROM N. LINE

_____ FT. FROM S. LINE

_____ FT. FROM E. LINE

_____ FT. FROM W. LINE

LOCATION _____

RIG UP _____

DRILLING AND REMARKS:



RECORD

CASED _____ IN. _____ FT.

SAND _____

GAS _____

OIL _____

TOTAL DEPTH 800

PRODUCTION

1ST 24 HRS. NAT. _____

1ST 24 HRS. AFTER SHOT _____

GAS _____ Cu. Ft.

DRY HOLE

ABANDONED

DATE

2/26 1928 SCOUT