


Section 23 Township 23 Range 9-E

Well No. #1 Tetter

Company McGennis & Derby Drlg

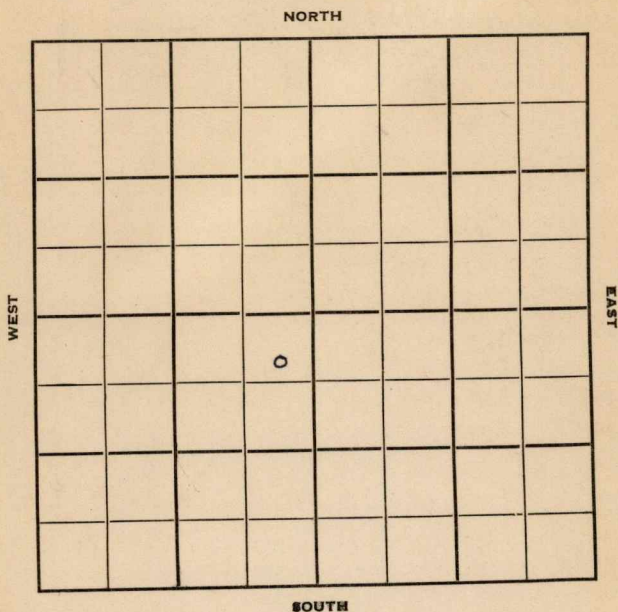

Greenwood

KANSAS

Sec. 23 Twp. 23 R. 9E

Well No. #1 Tetter Farm

McGennis & Derby Drlg. Company

Contractor

Wildcat


550' Ft. from N. Line

Ft. from S. Line

330' Ft. from E. Line

Ft. from W. Line

NE NE SW Twin Well

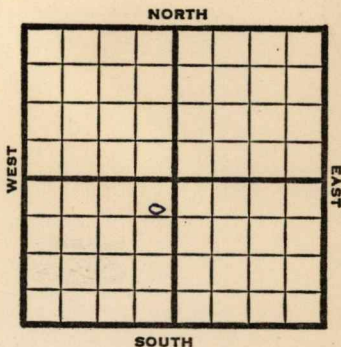

1950

?

REPORT

5/24

8" @ 100'

7/19

8" @ 100

Bart 2221-33

5" @ 2222

TD 2260

D&A

ABANDONED

Kansas

Map No. \_\_\_\_\_ Sec. 23 Twp. 23 R. 9EWell No. 1 TettarMcGennis & Derby Drlg. Company

Contractor

NE NE SW twin well

## SECTION PLAT

550 Ft. from N. Line

\_\_\_\_\_ Ft. from S. Line

330 Ft. from E. Line

\_\_\_\_\_ Ft. from W. Line

|              |   |  |  |
|--------------|---|--|--|
|              |   |  |  |
| FIRST REPORT |   |  |  |
|              | 0 |  |  |
|              |   |  |  |

Greenwood

Location \_\_\_\_\_

Rig up \_\_\_\_\_

Drilling and Remarks:

8" @ 100

## RECORD

Cased \_\_\_\_\_ in., \_\_\_\_\_ ft.

Sand \_\_\_\_\_

Gas \_\_\_\_\_

Oil \_\_\_\_\_

Total Depth \_\_\_\_\_

## PRODUCTION

1st 24 hrs. Nat. \_\_\_\_\_

1st 24 hrs. after shot \_\_\_\_\_

Gas \_\_\_\_\_ Cu. Ft.

Dry Hole \_\_\_\_\_

Abandoned \_\_\_\_\_

Date

MAY 24 1950

19

J. E. TYRA

Scout

~~Kansas~~Map No. \_\_\_\_\_ Sec. 23 Twp. 23 R. 9EWell No. 1 TetterMcGinnis & Derby Drlg. Company

Contractor

NE NE SW


## SECTION PLAT

550 Ft. from N. Line

\_\_\_\_\_ Ft. from S. Line

330 Ft. from E. Line

\_\_\_\_\_ Ft. from W. Line

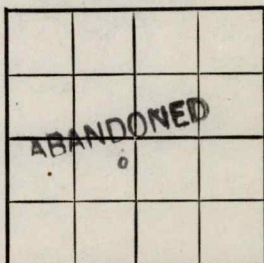Greenwood Countytwin well

Location \_\_\_\_\_

Rig up \_\_\_\_\_

Drilling and Remarks:

8" @ 100

Bart. 2221-33

5" @ 2222

TD 2260

D &amp; A

## RECORD

Cased \_\_\_\_\_ in., \_\_\_\_\_ ft.

Sand \_\_\_\_\_

Gas \_\_\_\_\_

Oil \_\_\_\_\_

Total Depth 2260

## PRODUCTION

1st 24 hrs. Nat. \_\_\_\_\_

1st 24 hrs. after shot \_\_\_\_\_

Gas \_\_\_\_\_ Cu. Ft.

Dry Hole \_\_\_\_\_

Abandoned \_\_\_\_\_

Date JUL 19 1950

19

J. E. TYRA Scout