

KANSAS
Butler

Section 21 Township 27 Range 3E

Well No. 1 Skaer

Company D R Lauch

Misc.
NORTH

WEST

EAST

SOUTH

KANSAS

Butler

Sec. 21 Twp. 27 R. 3E ✓

Well No. #1 Skaer Farm

D. R. Lauch Company

Miscellaneous


330' Ft. from N. Line

Ft. from S. Line

Ft. from E. Line

330' Ft. from W. Line

NW SW

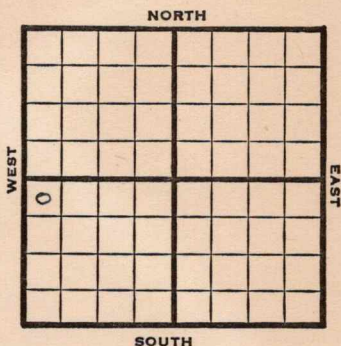

1948

Elev. 1309' REPORT

9/15 Location

9/21 8" @ 130'

9/29 KC 2333'
Mississippi 2802'
Drlg. 2973
10/6 Simp 3071' °
Arbuckle 3150'
TD 3163'

ABANDONED

Map No. 121 Sec. 21 Twp. 27 R. 3E

Well No. 1 Skaer

D. R. Lauch Company

ABANDONED

Contractor

NW SW

E1.1309

SECTION PLAT

330 Ft. from N. Line

 Ft. from S. Line

 Ft. from E. Line

330 Ft. from W. Line

6			

Butler County

Location

Rig up

Drilling and Remarks:

Swing 3091
Ar Y 3150

RECORD

Cased in., ft.

Sand

Gas

Oil

Total Depth 3163

PRODUCTION

1st 24 hrs. Nat.

1st 24 hrs. after shot

Gas Cu. Ft.

Dry Hole

Abandoned

Date

OCT 6 1948

19

S. J. LEWIS

Scout