

KANSAS

Butler

Section 13 Township 25 Range 4E

Well No. #4 Morgan

Company Ralph Wixson

Miscellaneous

NORTH

WEST

EAST

SOUTH

KANSAS

Butler



Sec. 13 Twp. 25 R. 4E

Well No. #4 Morgan Farm

Ralph Wixson Company


Misc.

 Ft. from N. Line

330 Ft. from S. Line

 Ft. from E. Line

330 Ft. from W. Line

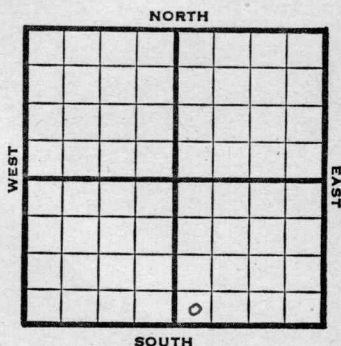

SW SE

1947

Elev. 1404' REPORT

12/3 Machine.

12/10 15" @ 230'
Drlg. 400'

12/17 Drlg. 1030'

12/30 12" @ 910'
Mississippi 2580'
TD 2594'
7" @ 2589'

1948
1/7 TD 2608'

1/14 Miss. 2580'
7" @ 2589'
Pump 50 Pot
38.0 Gr.
TD 2608'

COMPLETED

Map No. _____ Sec. 13 Twp. 25 R. 4E

Well No. 4 Morgan

Ralph Wixson Company

FIRST REPORT

Contractor

SW SE

SECTION PLAT

_____ Ft. from N. Line

330 Ft. from S. Line

_____ Ft. from E. Line

330 Ft. from W. Line

Butler County

Location _____

Rig up _____

Drilling and Remarks:

Machine

RECORD

Cased _____ in., _____ ft.

Sand _____

Gas _____

Oil _____

Total Depth _____

PRODUCTION

1st 24 hrs. Nat. _____

1st 24 hrs. after shot _____

Gas _____ Cu. Ft.

Dry Hole _____

Abandoned _____

Date

DEC 3 1947 19

S. J. LEWIS Scout

Map No. 14 Sec. 13 Twp. 25 R. 4E

Well No. 4 Morgan


Ralph Wixson Company

COMPLETE

Contractor

SW SE

E. 1404
SECTION PLAT

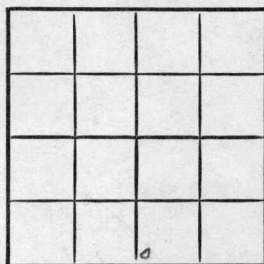

 Ft. from N. Line

330 Ft. from S. Line

 Ft. from E. Line

330 Ft. from W. Line

Butler County

Location

Rig up

Drilling and Remarks:

Miss 2580

7" @ 2589

Pump 50 ft

0804

RECORD

Cased in., ft.

Sand

Gas

Oil

Total Depth 2605

PRODUCTION

1st 24 hrs. Nat.

1st 24 hrs. after shot

Gas Cu. Ft.

Dry Hole

Abandoned

Date

JAN 14 1948

19

S. J. LEWIS

Scout