


Map No. _____ Sec. 27 Twp. 23 R. 9
 Well No. 1- Peeters-Landerman Farm
Monitor & Atlas Company

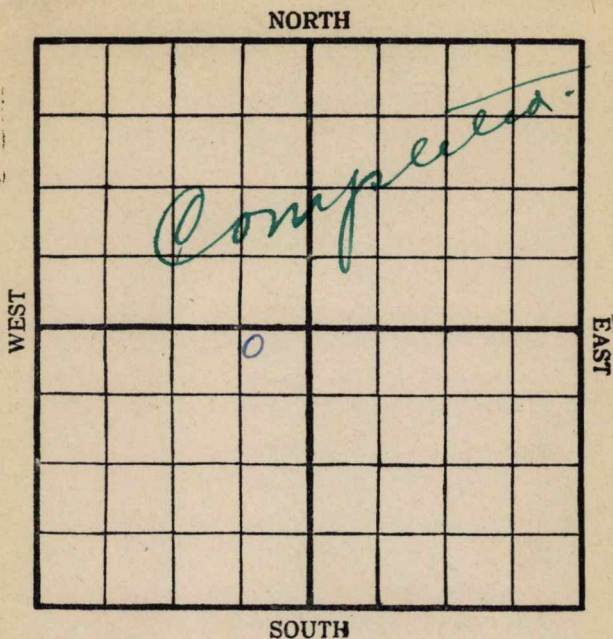

Location _____

Drilling Remarks:

25 Bbla.

2D. 2424.

Rig Up _____

Drilling Remarks:

6/1/8

RECORD

Cased _____ in. _____ ft.
 Sand _____
 Gas _____
 Oil _____
 Total Depth _____


PRODUCTION

1st 24 hrs. Nat. _____
 1st 24 hrs. after shot _____
 Gas _____ cu. ft
 Dry Hole _____
 Abandoned _____

Map No. K15 Sec. 27 Twp. 23 R. 9
 Well No. 1 Teeters Farm
Monitor Oil Atlas Company

NORTH

WEST

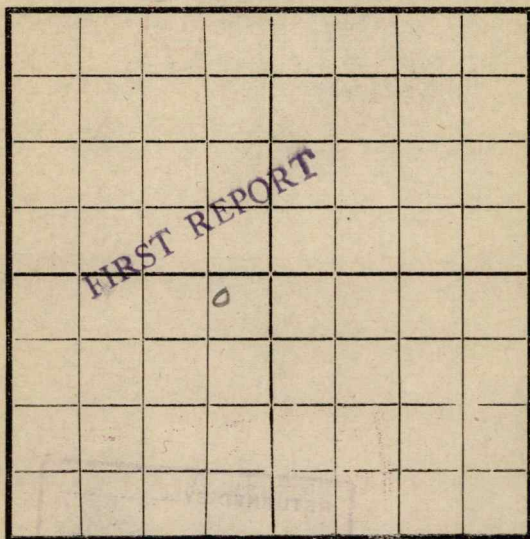

EAST

SOUTH

Location -----

Rig Up ☒ -----

Drilling and remarks -----

RECORD

Cased ----- in. ----- Ft.

Sand -----

Gas -----

Oil -----

Total Depth -----

PRODUCTION

1st 24 hrs. Nat. -----

1st 24 hrs. after shot -----

Gas ----- Cu. Ft.

Dry Hole -----

Abandoned -----


Date

11/24, 1917 D. J. L. Scout

Map No. _____ Sec. 27 Twp. 23 R. 9Well No. 1 Testers Farm _____
Monitor Company _____

NORTH

WEST

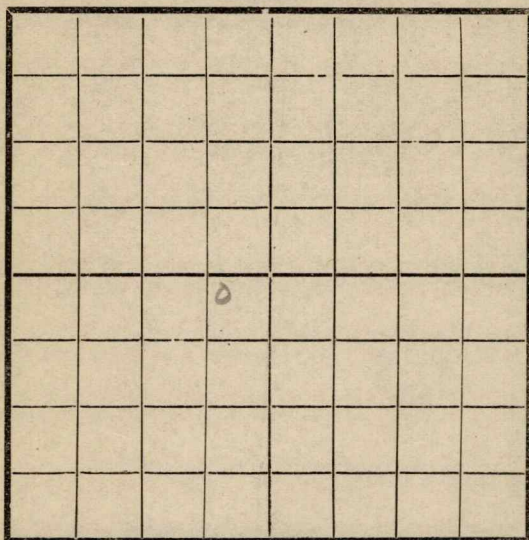

EAST

SOUTH

Location ✓Rig Up ✓

Drilling and remarks

RECORD

Cased _____ in. _____ Ft.

Sand _____

Gas _____

Oil _____

Total Depth _____

PRODUCTION

1st 24 hrs. Nat. _____

1st 24 hrs. after shot _____

Gas _____ Cu. Ft.

Dry Hole _____

Abandoned _____


Date

11/29, 1917 Pyle Scout

Map No. _____ Sec. 27 Twp. 23 R. 9
 Well No. 1 Landeragan Farm _____
 _____ Company _____

NORTH

WEST

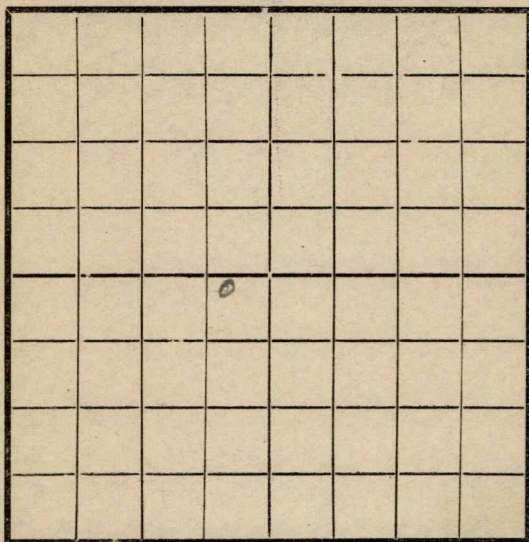

EAST

SOUTH

Location _____
 Rig Up ☒ _____
 Drilling and remarks _____

RECORD

Cased _____ in. _____ Ft.
 Sand _____
 Gas _____
 Oil _____
 Total Depth _____

PRODUCTION

1st 24 hrs. Nat. _____
 1st 24 hrs. after shot _____
 Gas _____ Cu. Ft.
 Dry Hole _____
 Abandoned _____

Date

12/5, 1917 Pyle Scout

Map No. _____ Sec. 27 Twp. 23 R. 9
Well No. 1 Landingan Farm _____
Atlas et al Company _____

NORTH

WEST

EAST

SOUTH

Location -----
Rig Up -----
Drilling and remarks

S.O.
for
water

RECORD

Cased _____ in. _____ Ft.
 Sand _____
 Gas _____
 Oil _____
 Total Depth _____

PRODUCTION

1st 24 hrs. Nat. _____
1st 24 hrs. after shot _____
Gas _____ Cu. Ft. _____
Dry Hole _____
Abandoned _____

Date _____

-----, 191----- Scout

Map No. _____ Sec. 27 Twp. 23 R. 9
Well No. 1 Handerson Farm
Atlas et al Company

NORTH

WEST

EAST

SOUTH

Location _____
Rig Up ☒ _____
Drilling and remarks _____

RECORD

Cased _____ in. _____ Ft.
 Sand _____
 Gas _____
 Oil _____
 Total Depth _____

PRODUCTION


1st 24 hrs. Nat.
1st 24 hrs. after shot.....
Gas..... Cu. Ft.
Dry Hole.....
Abandoned.....

Date _____

Date 2/1, 1918. Pyle Scout

Map No. _____ Sec. 27 Twp. 23 R. 9
 Well No. 1 Landeragan Farm _____
Atlas et al Company _____

NORTH

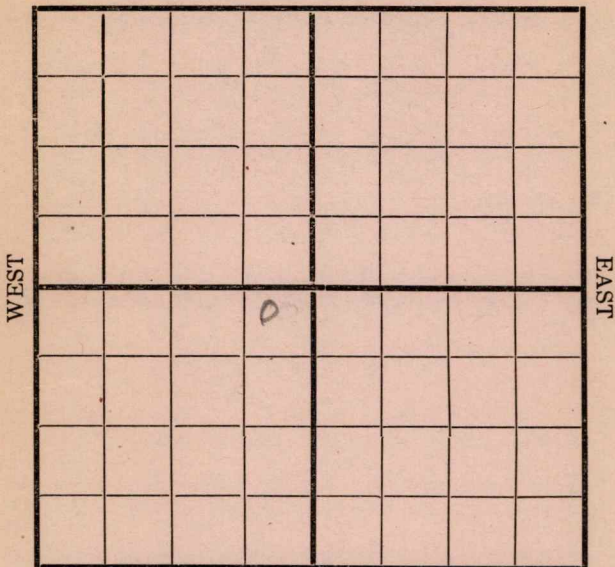

SOUTH

Location _____
 Rig Up _____
 Drilling and remarks _____

RECORD

Cased _____ in. _____ Ft.
 Sand _____
 Gas _____
 Oil _____
 Total Depth _____

PRODUCTION


1st 24 hrs. Nat. _____
 1st 24 hrs. after shot _____
 Gas _____ Cu. Ft.
 Dry Hole _____
 Abandoned _____

Date 2/7, 1918 J. H. C. J. H. C. Scout

Map No. _____ Sec. 27 Twp 23 R. 9Well No. 1 Landeragan Farm
Atlas et al Company

NORTH

WEST

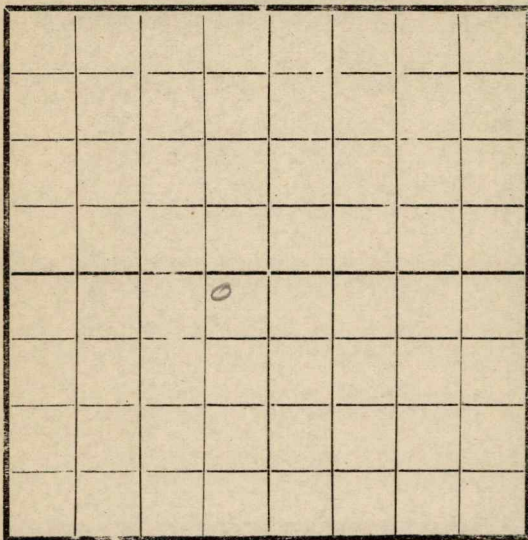

EAST

SOUTH

Location _____

Rig Up _____

Drilling and remarks

Spud

RECORD

Cased _____ in. _____ Ft.

Sand _____

Gas _____

Oil _____

Total Depth _____

PRODUCTION

1st 24 hrs. Nat. _____

1st 24 hrs. after shot _____

Gas _____ Cu. Ft.

Dry Hole _____

Abandoned _____


Date

2/14, 191*8* *Tyle* Scout

Map No. _____ Sec. 27 Twp. 23 R. 9
 Well No. 1 Landingan Farm _____
Atlas et al Company _____

NORTH

WEST

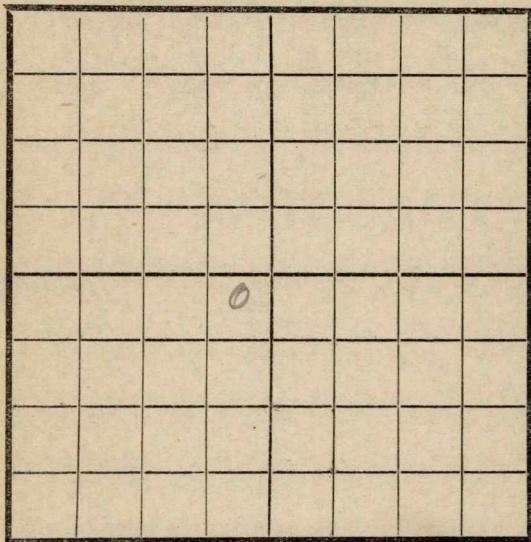

EAST

SOUTH

RECORD	
Location _____	Cased _____ in. _____ Ft.
Rig Up _____	Sand _____
Drilling and remarks <u>400'</u>	Gas _____
	Oil _____
	Total Depth _____
	PRODUCTION
	1st 24 hrs. Nat. _____
	1st 24 hrs. after shot _____
	Gas _____ Cu. Ft.
	Dry Hole _____
	Abandoned _____


Date

2/22, 1918 Pyle Scout

Map No. _____ Sec. 27 Twp. 23 R. 9
 Well No. 1 Landingan Farm _____
Atlas et al Company _____

NORTH

WEST

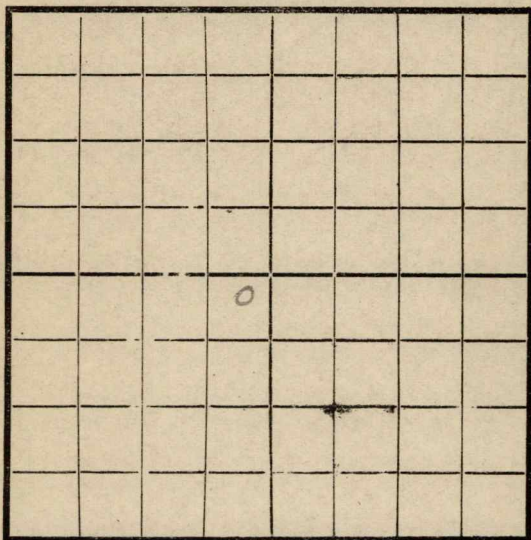

EAST

SOUTH

Location _____

Rig Up _____

Drilling and remarks

650'

RECORD

Cased _____ in _____ Ft.

Sand _____

Gas _____

Oil _____

Total Depth _____

PRODUCTION

1st 24 hrs. Nat. _____

1st 24 hrs. after shot _____

Gas _____ Cu. Ft.

Dry Hole _____

Abandoned _____

Date


3/8, 191

Gyle Scout

Map No. _____ Sec. 27 Twp. 23 R. 9Well No. 1 Handeryan Farm _____Atlas et al Company _____

NORTH

WEST

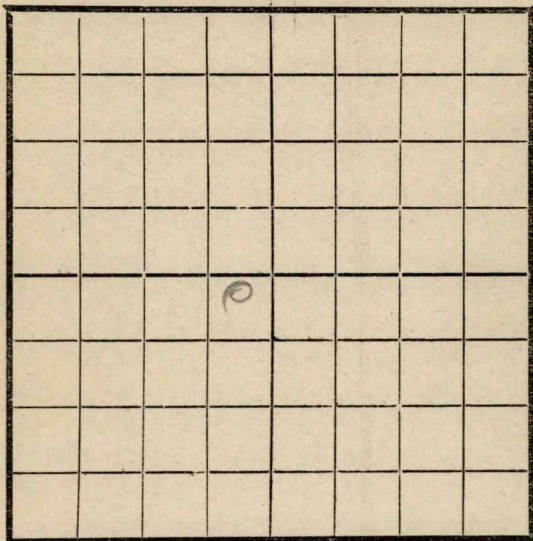

EAST

SOUTH

Location _____

Rig Up _____

Drilling and remarks

RECORD

Cased _____ in. _____ Ft.

Sand _____

Gas _____

Oil _____

Total Depth _____

PRODUCTION

1st 24 hrs. Nat. _____

1st 24 hrs. after shot _____

Gas _____ Cu. Ft.

Dry Hole _____

Abandoned _____

Date


3/9, 1918 Dry _____ Scout _____

Map No. _____ Sec. 27 Twp. 23 R. 9
 Well No. 1 Landergan Farm
Atlas et al Company

NORTH

WEST

EAST

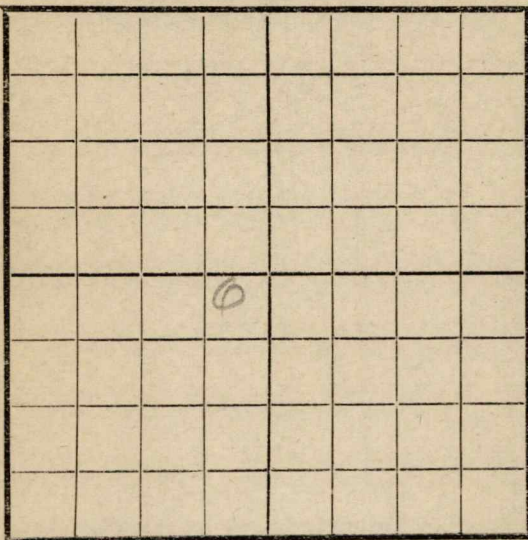

SOUTH

Location _____

Rig Up _____

Drilling and remarks

1400'

RECORD

Cased _____ in. _____ Ft.

Sand _____

Gas _____

Oil _____

Total Depth _____

PRODUCTION

1st 24 hrs. Nat. _____

1st 24 hrs. after shot _____

Gas _____ Cu. Ft.

Dry Hole _____

Abandoned _____


Date

3/14, 1918 C. J. C. C. Scout

Map No. _____ Sec. 27 Twp. 23 R. 9
 Well No. 1 Landergan Farm
Atlas et al Company

NORTH

WEST

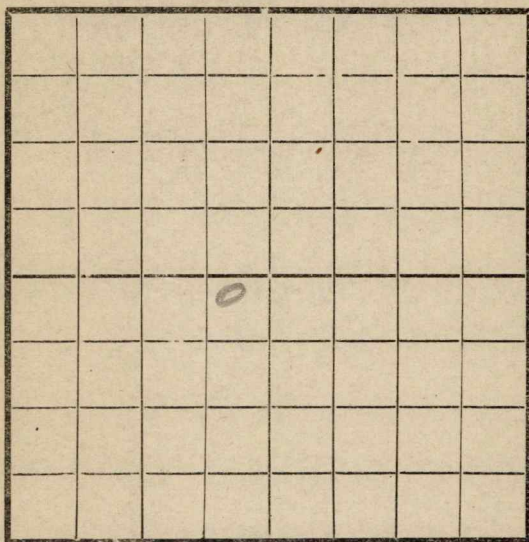

EAST

SOUTH

Location _____
 Rig Up _____
 Drilling and remarks

RECORD

Cased _____ in. _____ Ft.
 Sand _____
 Gas _____
 Oil _____
 Total Depth _____

PRODUCTION


1st 24 hrs. Nat. _____
 1st 24 hrs. after shot _____
 Gas _____ Cu. Ft.
 Dry Hole _____
 Abandoned _____

Date

3/22, 1918 Oyle Scout

Map No. _____ Sec. 27 Twp. 23 R. 9
Well No. 1 Landeragan Farm _____
Atlas et al Company _____

NORTH

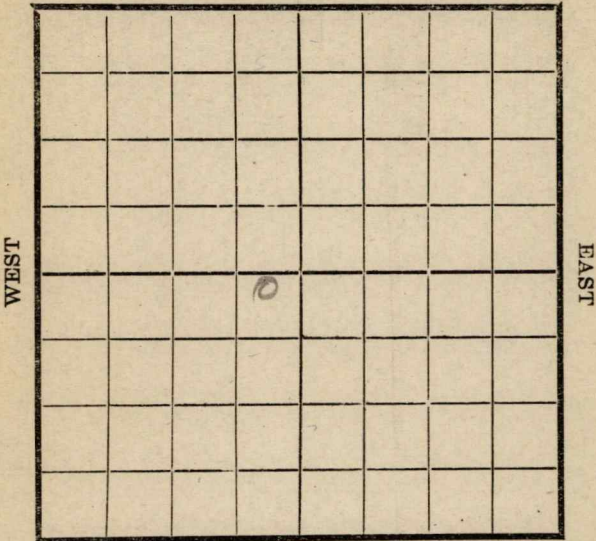

SOUTH


	RECORD
Location _____	Cased _____ in. _____ Ft.
Rig Up _____	Sand _____
Drilling and remarks	Gas _____
<u>D. 10 @</u> <u>1600'</u>	Oil _____
	Total Depth _____
	PRODUCTION
	1st 24 hrs. Nat. _____
	1st 24 hrs. after shot _____
	Gas _____ Cu. Ft.
	Dry Hole _____
	Abandoned _____

Date 3/30, 1918 Oyle Scout

Map No. _____ Sec. 27 Twp. 23 R. 9
 Well No. 1 Landeragan Farm _____
Atlas et al Company _____

NORTH

WEST

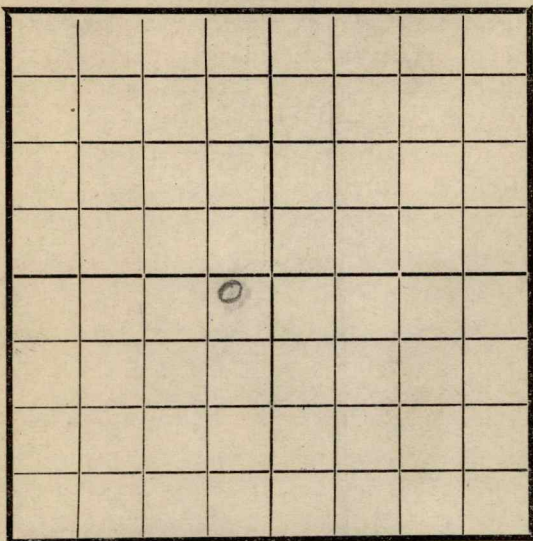

EAST

SOUTH

Location _____

Rig Up _____

Drilling and remarks

fishing @
2100'

RECORD

Cased _____ in _____ Ft.

Sand _____

Gas _____

Oil _____

Total Depth _____

PRODUCTION

1st 24 hrs. Nat. _____

1st 24 hrs. after shot _____

Gas _____ Cu. Ft.

Dry Hole _____

Abandoned _____


Date

4/8, 191*8* *Oyle* Scout

Map No. _____ Sec. 27 Twp. 23 R. 9Well No. 1 Landeragan FarmAtlas et al Company

NORTH

WEST

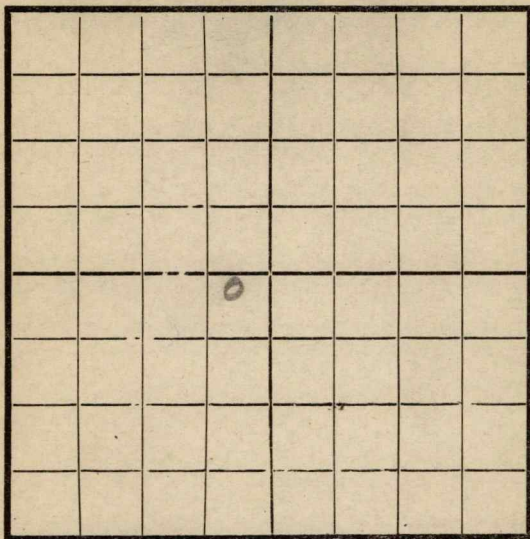

EAST

SOUTH

Location _____

Rig Up _____

Drilling and remarks

fishing @
2100'

RECORD

Cased _____ in. _____ Ft.

Sand _____

Gas _____

Oil _____

Total Depth _____

PRODUCTION

1st 24 hrs. Nat. _____

1st 24 hrs. after shot _____

Gas _____ Cu. Ft.

Dry Hole _____

Abandoned _____


Date

4/12, 1918Pyle Scout

Map No. _____ Sec. 27 Twp. 23 R. 9
 Well No. 1 Landeran Farm _____
atlas et al Company _____

NORTH

WEST

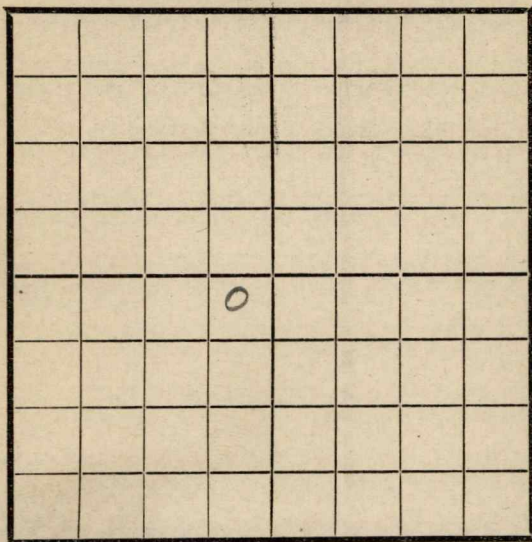

EAST

SOUTH

Location _____

Rig Up _____

Drilling and remarks

fishing for
tools 2250'

RECORD

Cased _____ in. _____ Ft.

Sand _____

Gas _____

Oil _____

Total Depth _____

PRODUCTION

1st 24 hrs. Nat. _____

1st 24 hrs. after shot _____

Gas _____ Cu. Ft.

Dry Hole _____

Abandoned _____

Date

4/20, 1918 Cy h Scout _____

Map No. _____ Sec. 27 Twp. 23 R. 9
 Well No. 1 Landerigan Farm _____
Atlas et al Company _____

NORTH

WEST

EAST

SOUTH

Location _____

Rig Up _____

Drilling and remarks

fishing for
tools @
2250

RECORD

Cased _____ in. _____ Ft.

Sand _____

Gas _____

Oil _____

Total Depth _____

PRODUCTION

1st 24 hrs. Nat. _____

1st 24 hrs. after shot _____

Gas _____ Cu. Ft.

Dry Hole _____

Abandoned _____

Date


4/8
27 191 *8*

Scout

Map No. _____ Sec. 27 Twp. 23 R. 9
 Well No. 1 Landeragan Farm _____
Atlas et al Company _____

NORTH

WEST

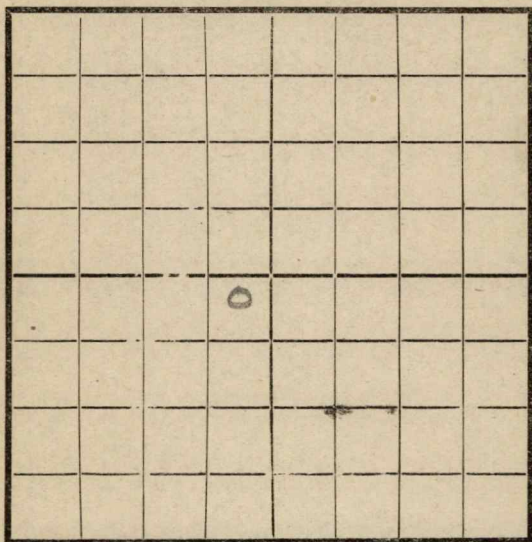

EAST

SOUTH

Location _____

Rig Up _____

Drilling and remarks

fishing @
2250'

RECORD

Cased _____ in. _____ Ft.

Sand _____

Gas _____

Oil _____

Total Depth _____

PRODUCTION

1st 24 hrs. Nat. _____

1st 24 hrs. after shot _____

Gas _____ Cu. Ft.

Dry Hole _____

Abandoned _____


Date

5/4, 191*8* *Cyle* Scout

Map No. _____ Sec. 27 Twp. 23 R. 9
 Well No. 1 Lindergran Farm
Atlas et al Company

NORTH

WEST

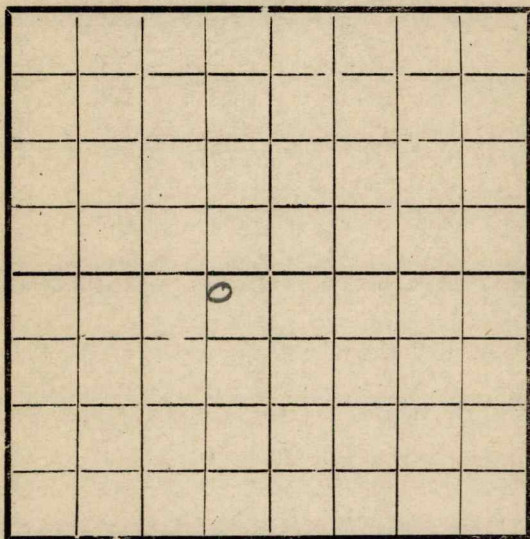

EAST

SOUTH

Location _____

Rig Up _____

Drilling and remarks

top sand

2399

2414

DD for 5 3/4

Date

very light showing

5/8, 191

Scout

RECORD

Cased _____ in. _____ Ft.

Sand _____

Gas _____

Oil _____

Total Depth _____

PRODUCTION

1st 24 hrs. Nat. _____

1st 24 hrs. after shot _____

Gas _____ Cu. Ft.

Dry Hole _____

Abandoned _____

Map No. _____ Sec. 27 Twp. 23 R. 9
 Well No. 1 Sandigan
Atlas et al Company
 Contractor _____

NORTH

WEST

EAST

SOUTH

Location _____

Rig up _____

Drilling and Remarks:

350' oil in
hole (parted
pipe) —
— fishing

RECORD

Cased _____ in., _____ ft.

Sand 2399-2414

Gas _____

Oil _____

Total Depth 2424

PRODUCTION

1st 24 hrs. Nat. _____

1st 24 hrs. after shot _____

Gas _____ Cu. Ft.

Dry Hole _____

Abandoned _____

Date

5/18 1918 Pyle Scout

Map No. _____ Sec. 27 Twp. 23 R. 9
 Well No. 1 Landeragan
Atlas et al Company
 _____ Contractor

NORTH

WEST

EAST

SOUTH

Location _____

Rig up _____

Drilling and Remarks:

*fishing
for part of
casing
300' oil line
hole*

RECORD

Cased _____ in., _____ ft.

Sand _____

Gas _____

Oil _____

Total Depth _____

PRODUCTION

1st 24 hrs. Nat. _____

1st 24 hrs. after shot _____

Gas _____ Cu. Ft.

Dry Hole _____

Abandoned _____

Date

2474-2424

191

Scout

Map No. _____ Sec. 27 Twp. 23 R. 9
Well No. 19 Anderson
Atlas et al _____ Company

Contractor _____

NORTH

WEST

EAST

SOUTH

Location _____

Rig up.....

Drilling and Remarks:

fishing
casing
24/4

RECORD

Cased-----in., -----ft.

Sand.....

Gas -----

Oil _____

Total Depth_____

PRODUCTION

1st 24 hrs. Nat. -----

1st 24 hrs. after shot-----

Gas.....Cu. Ft.

Dry Hole

Abandoned.....

Date _____

191

Scout


Map No. 15 Sec. 27 Twp. 23 R. 9Well No. 1 TanderganAtlas et al Company

Contractor

NORTH

WEST

EAST

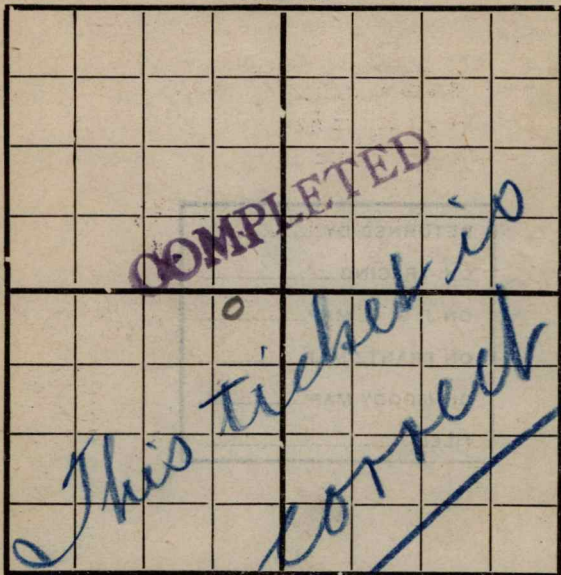

SOUTH

Location _____

Rig up _____

Drilling and Remarks:

Shot 10 gtsEst. 25 bbls

RECORD

Cased _____ in., _____ ft.

Sand 2399-2414

Gas _____

Oil _____

Total Depth 2424

PRODUCTION

1st 24 hrs. Nat. _____

1st 24 hrs. after shot _____

Gas _____ Cu. Ft.

Dry Hole _____

Abandoned _____

Date


4/7

191

89

Scout

Map No. K 15 Sec. 27 Twp. 23 R. 9
 Well No. 1 Landeragan Farm
Atlas et al Company
 Date Started _____ Ft. from N. S. E. W. line
NORTH

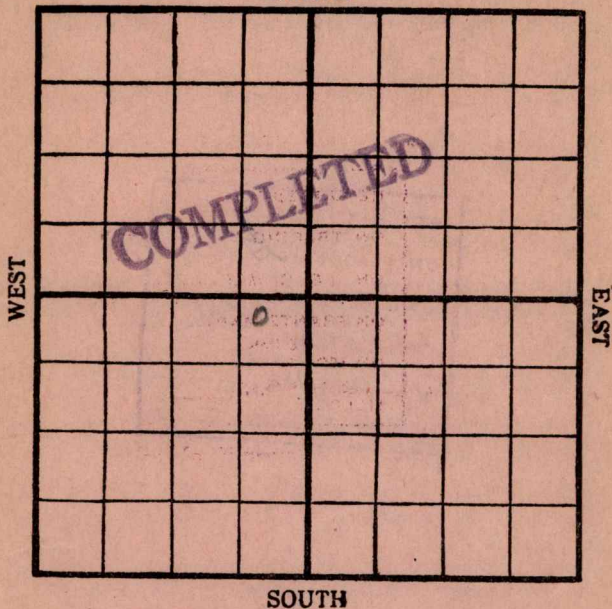

Cased _____ In. _____ Ft. _____
 Sand 2399-2414
 Pay { Gas _____
 { Oil _____
 Total Depth 2424

Production Remarks

shot 10 qts

Condition of Well on this date _____

Pumped 40 bbls

1st 24 hrs

P. y. h

7/6 Scout