


Coffey

Map No. _____ Sec. *12* Twp. *23* R. *14* ^E

Well No. *4 Samrocked* Farm _____

Hinge *et al* Company _____

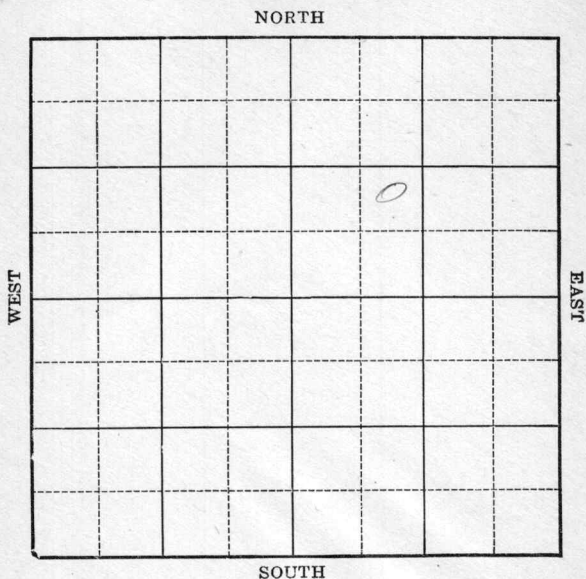

Location _____
Drilling Remarks _____

Rig Up _____
Drilling Remarks _____

RECORD

Cased _____ in. _____ ft.
Sand _____
Gas _____
Oil _____
Total Depth _____

PRODUCTION

1st 24 hrs. Nat. _____
1st 24 hrs. after shot _____
Gas _____ cu. ft.
Dry Hole _____
Abandoned _____

Coffee

Map No. KANSAS Sec. 12 Twp. 23 R. 14^E

Well No. 4 Vamocho Farm


Hunze et-al Company

 Ft. from N. Line

1070 Ft. from S. Line

 Ft. from E. Line

1070 Ft. from W. Line

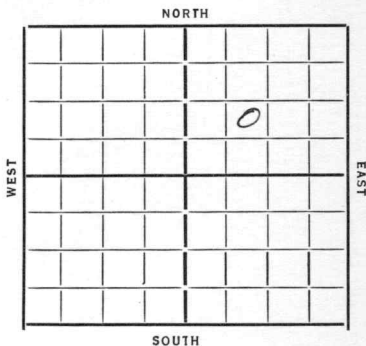

Date 1933

REPORT

12/6 hllg 1925'
12/12 Corrected to 1522 S.D.
12/27 — 14 —
1/11 Sand 1526 - T.D. 1568
300' oil
Treated with 500 gal acid
1/17 —
1/24 Sand 1526 T.D. 1568
500 gallon acid
5 bbls oil
100 water

COMPLETED

Map No. 17 Sec. 12 Twp. 23 R. 14EWell No. 4-VannockHinze et al Company

Contractor

COMPLETED

SECTION PLAT

		0	

Ft. from N. Line

1070 Ft. from S. Line

Ft. from E. Line

1070 Ft. from W. Line

Location.....

Rig up.....

Drilling and Remarks:

500 gal oil5 bbls oil
100 water

RECORD

Cased.....in.ft.

Sand 1526

Gas.....

Oil.....

Total Depth 1568

PRODUCTION

1st 24 hrs. Nat.....

1st 24 hrs. after shot.....

Gas.....Cu. Ft.

Dry Hole.....

Abandoned.....

Date

1-24-34 192.....O. Manschreck Scout

Map No. 17 Sec. 12 Twp. 23 R. 14E

Well No. 4-Vannock

Henze et al Company

Contractor

FIRST REPORTS

SECTION PLAT

		0	

Ft. from N. Line

1070 Ft. from S. Line

Ft. from E. Line

1070 Ft. from W. Line

Location

Rig up

Drilling and Remarks:

RECORD

Cased in., ft.

Sand

Gas

Oil

Total Depth

PRODUCTION

1st 24 hrs. Nat.

1st 24 hrs. after shot

Gas Cu. Ft.

Dry Hole

Abandoned

Date

12-6-33 192 O. W. Mannschreck Scout