


Butler

Form 51-5M-4-27-27423

Map No. **KANSAS** Sec. 24 Twp. 27 R. 3E

Well No. 1-Bausinger Farm
Larobb Drilling Company

NORTH

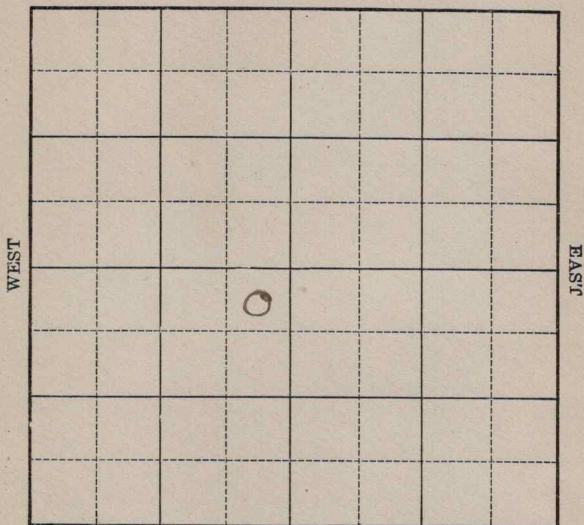

Location _____

Drilling Remarks _____

Rig Up _____

Drilling Remarks _____

RECORD

Cased _____ in. _____ ft.

Sand _____

Gas _____

Oil _____

Total Depth _____

PRODUCTION

1st 24 hrs. Nat. _____

1st 24 hrs. after shot _____

Gas _____ cu. ft.

Dry Hole _____

Abandoned _____

KANSAS

Map No. _____ Sec. 24 Twp. 27 R. 3E

Well No. 1 - Bausinger Farm


Laroff & Co Company

330 Ft. from N. Line

_____ Ft. from S. Line

330 Ft. from E. Line

_____ Ft. from W. Line

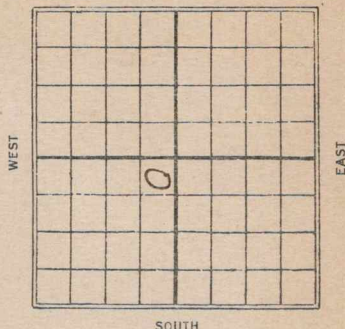

1927

Date REPORT

<u>9/7</u>	<u>Rig</u>		
<u>9/14</u>	_____	<u>1/31</u>	<u>Rig</u>
<u>9/20</u>	_____	<u>2/15</u>	<u>7/11 - Rig</u>
<u>9/28</u>	_____	<u>2/22</u>	<u>7/18</u>
<u>10/5</u>	_____	<u>2/29</u>	<u>7/25</u>
<u>10/12</u>	_____	<u>3/7</u>	<u>8/1</u>
<u>10/19</u>	_____	<u>3/14</u>	<u>8/7</u>
<u>10/26</u>	_____	<u>3/21</u>	<u>8/15 - Rig in up</u>
<u>11/2</u>	_____	<u>3/28</u>	<u>8/22</u>
<u>11/9</u>	_____	<u>4/4</u>	<u>9/5</u>
<u>11/16</u>	_____	<u>4/11</u>	<u>9/12</u>
<u>11/22</u>	_____	<u>4/18</u>	<u>9/19</u>
<u>11/29</u>	_____	<u>4/25</u>	
<u>12/7</u>	_____	<u>5/2</u>	
<u>12/13</u>	_____	<u>5/9</u>	
<u>12/21</u>	_____	<u>5/16</u>	
<u>12/28</u>	_____	<u>5/23</u>	
<u>1928</u>	<u>✓</u>	<u>5/31</u>	
<u>1/4</u>	_____	<u>6/6</u>	
<u>1/11</u>	_____	<u>6/13</u>	
<u>1/18</u>	_____	<u>6/20</u>	
<u>1/25</u>	_____	<u>6/27</u>	
		<u>7/3</u>	

(over)

756787
9/26 - Rigged up & S.D.

10/3

10/10

10/17

10/24

10/31

11/7

11/14

11/21

11/28

12/5

12/12

12/19

12/26

1929

1/2

1/9

1/16

1/23

1/30

2/6

2/13

2/20

2/27

3/6

3/13

3/20

3/27

4/3

4/10

4/17

4/24

5/1

5/8

5/15

5/22

5/29

6/4

Spdy.
dry 600'


Map No. *Kans.* Sec. *24* Twp. *27* R. *3E*
 Well No. *1- Bausinger* Farm
Jarobbs Drily Company

330 Ft. from N. Line

..... Ft. from S. Line

330 Ft. from E. Line

..... Ft. from W. Line

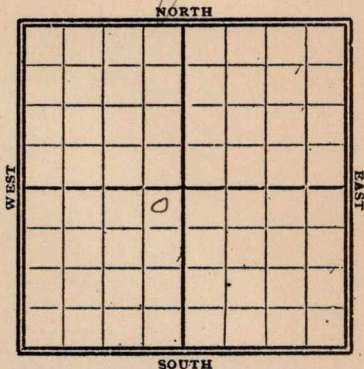

1929

Date	REPORT
<i>6/12</i>	<i>Drily 1360'</i>
<i>6/19</i>	<i>" 1900'</i>
<i>6/26</i>	<i>Small show at 2320'</i>
<i>7/2</i>	<i>SD. 2430' for 8" csg.</i>
<i>7/10</i>	
<i>7/17</i>	
<i>7/24</i>	<i>Drily 2450' 8"-2435'</i>
<i>8/1</i>	<i>Sp. Wilcox 3012-22</i>
	<i>1500' oil in 2 hrs</i>
	<i>Running tubing to pump</i>
<i>8/7</i>	<i>sand 3012-22'</i>
	<i>T.D. 3022'</i>
	<i>Pump 145 bbls oil</i>
	<i>43° gravity</i>
	<i>Comp.</i>


Map No. 12 **KANSAS** Sec. 24 Twp. 27 R. 3E

Well No. 1 Bawinger

Larson Drilling Company

Contractor

SECTION PLAT

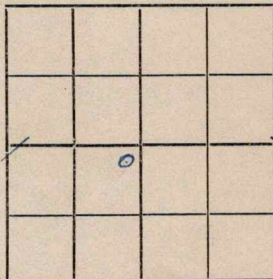

330 Ft. from N. Line

_____ Ft. from S. Line

330 Ft. from E. Line

_____ Ft. from W. Line

FIRST REPORTS

Location _____

Rig up _____

Drilling and Remarks:

Rig

RECORD

Cased _____ in., _____ ft.

Sand _____

Gas _____

Oil _____

Total Depth _____

PRODUCTION

1st 24 hrs. Nat. _____

1st 24 hrs. after shot _____

Gas _____ Cu. Ft.

Dry Hole _____

Abandoned _____

Date

SEP 7 1927

S. J. LEWIS

Scout

Butler

12 **KANSAS** Sec. 24 Twp. 27 R. 3^E

Well No. 1 Bausinger
 Karott Drly Co Company
 Contractor

COMPLETE**SECTION PLAT**

330 Ft. from N. Line

Ft. from S. Line

330 Ft. from E. Line

Ft. from W. Line

	0		

Location _____

Rig up _____

Drilling and Remarks:

Pungy 145 Bls

43 Grav.

RECORD

Cased 3 in., 3 ft.

Sand 2012-2022

Gas _____

Oil 3022

Total Depth 3022

PRODUCTION

1st 24 hrs. Nat. _____

1st 24 hrs. after shot _____

Gas _____ Cu. Ft.

Dry Hole _____

Abandoned _____

Date

AUG 7

1929

CHAS. L. SHERWOOD

19

Scout