

Map No. _____ Sec. 1 Twp. 28 R. 5
 Well No. 1- Natis Farm _____
Hoyt et al Company _____

NORTH

WEST

EAST



SOUTH

Location _____

Rig Up _____

Drilling Remarks:

Drilling Remarks:

RECORD

Cased _____ in. _____ ft.

Sand _____

Gas _____

Oil _____

Total Depth _____

PRODUCTION


1st 24 hrs. Nat. _____

1st 24 h's. after shot _____

Gas _____ cu. ft

Dry Hole _____

Abandoned _____

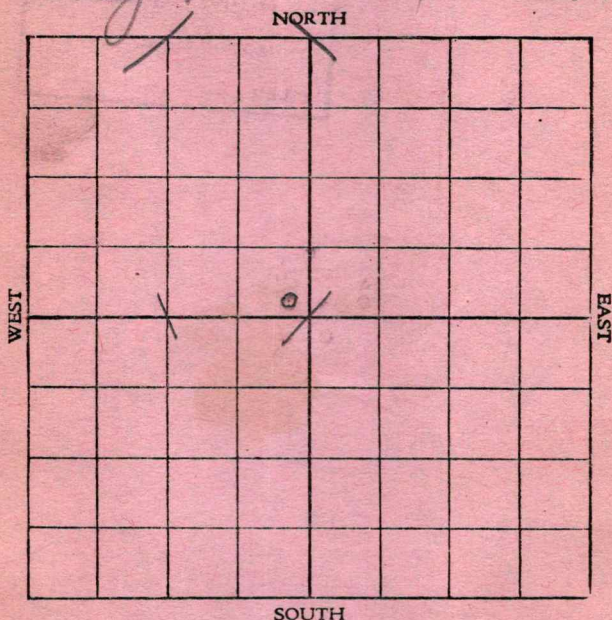Map No. _____ Sec. 1 Twp. 28 R. 5Well No. 1 Yates Farm _____Hoyt et al Company _____

Location _____

Rig up ☒ _____

Drilling and remarks:

RECORD

Cased _____ in. _____ Ft.

Sand _____

Gas _____

Oil _____

Total Depth _____

FIRST REPORT**PRODUCTION**

1st 24 hrs. Nat. _____

1st 24 hrs. after shot _____

Gas _____ Cu. Ft.

Dry Hole _____

Abandoned _____

Date

11/9, 1917, Co. 2 Scout

Map No. _____ Sec. 1 Twp. 28 R. 5


Well No. 1 Gates Farm

Wright et al Company

NORTH

WEST

EAST

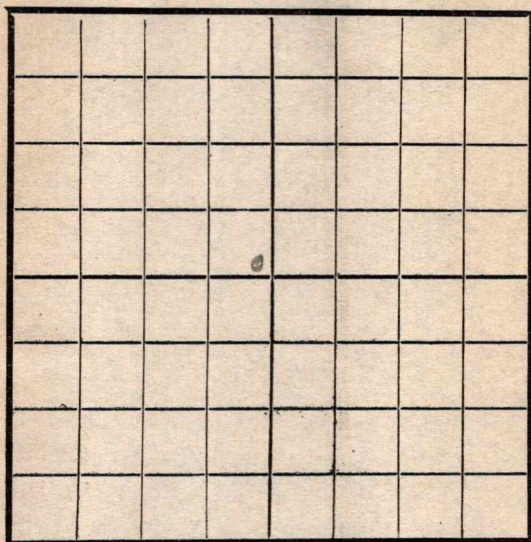

SOUTH

Location _____

Rig Up _____

Drilling and remarks _____

RECORD

Cased _____ in. _____ Ft.

Sand _____

Gas _____

Oil _____

Total Depth _____

PRODUCTION

1st 24 hrs. Nat. _____

1st 24 hrs. after shot _____

Gas _____ Cu. Ft.

Dry Hole _____

Abandoned _____


Date

11-14, 1917 Carney Scout

Map No. _____ Sec. 1 Twp. 28 R. 5Well No. 1 Yates Farm _____Haystack Company _____

NORTH

WEST

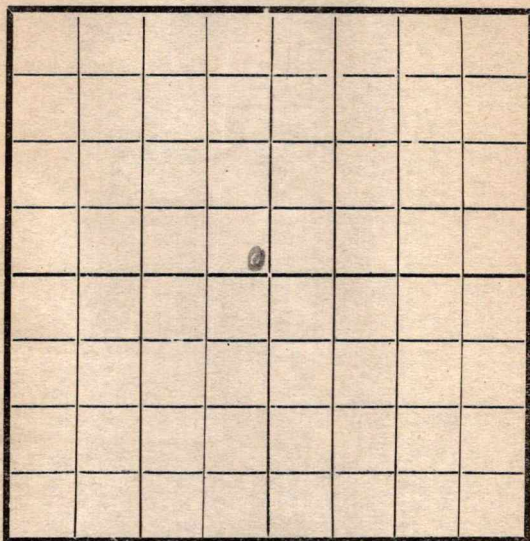

EAST

SOUTH

Location _____

Rig Up ☒ _____

Drilling and remarks _____

RECORD

Cased _____ in. _____ Ft.

Sand _____

Gas _____

Oil _____

Total Depth _____

PRODUCTION

1st 24 hrs. Nat. _____

1st 24 hrs. after shot _____

Gas _____ Cu. Ft.

Dry Hole _____

Abandoned _____


Date

11/21, 1912 Conley Scout

Map No. _____ Sec. 1 Twp. 38 R. 5Well No. 1 Yates Farm __________Hoyt et al Company

NORTH

WEST

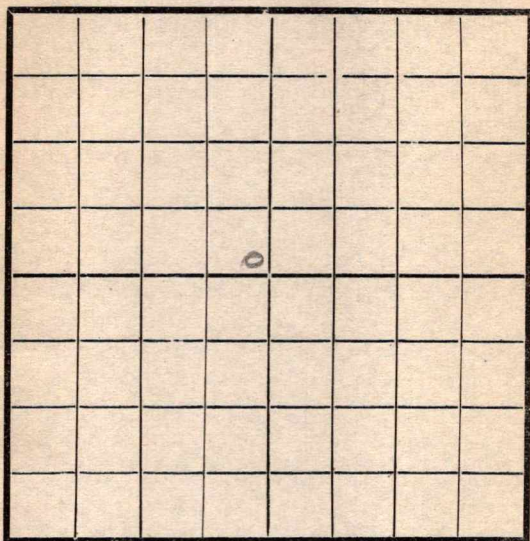

EAST

SOUTH

Location ✓Rig Up ✓

Drilling and remarks

RECORD

Cased _____ in. _____ Ft.

Sand _____

Gas _____

Oil _____

Total Depth _____

PRODUCTION

1st 24 hrs. Nat. _____

1st 24 hrs. after shot _____

Gas _____ Cu. Ft.

Dry Hole _____


Abandoned _____

Date

11/28, 1917 C. Condyff Scout

Map No. _____ Sec. 1 Twp. 28 R. 5
 Well No. 1 gates Farm _____
Holt et al Company _____
 NORTH

WEST

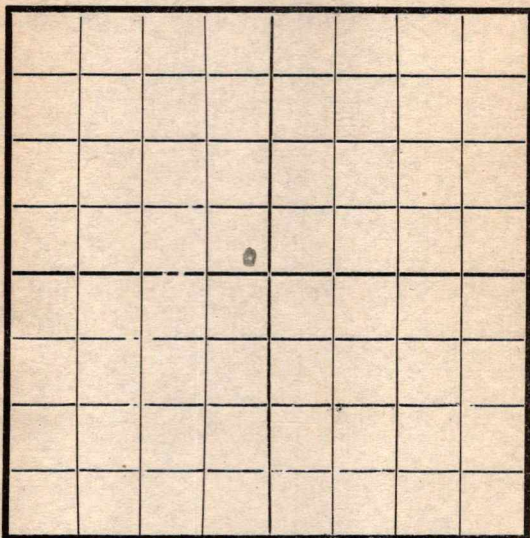

EAST

SOUTH

Location _____
 Rig Up _____
 Drilling and remarks

*Tools
moving
in*

RECORD

Cased _____ in. _____ Ft.
 Sand _____
 Gas _____
 Oil _____
 Total Depth _____

PRODUCTION

1st 24 hrs. Nat. _____
 1st 24 hrs. after shot _____
 Gas _____ Cu. Ft.
 Dry Hole _____
 Abandoned _____


Date

12/5, 1917 Candry Scout

Map No. _____ Sec. 1 Twp. 38 R. 5Well No. 1 gate Farm _____
Hayfield Company _____

NORTH

WEST

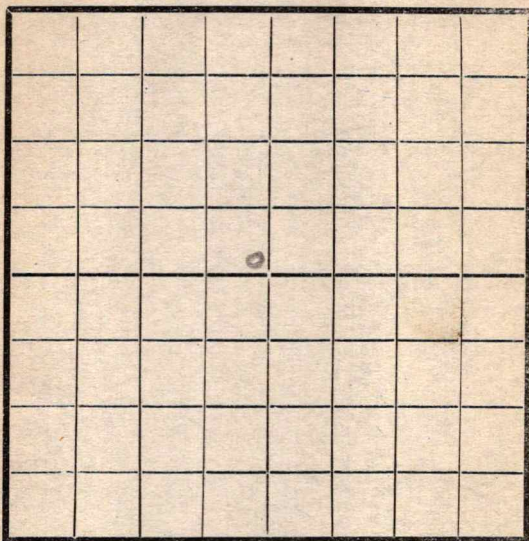

EAST

SOUTH

Location _____

Rig Up _____

Drilling and remarks

Rigged up

RECORD

Cased _____ in. _____ Ft.

Sand _____

Gas _____

Oil _____

Total Depth _____

PRODUCTION

1st 24 hrs. Nat. _____

1st 24 hrs. after shot _____

Gas _____ Cu. Ft.


Dry Hole _____

Abandoned _____

Date

12/12, 1917 Conroy Scout

Map No. _____ Sec. 1 Twp. 28 R. 5
Well No. 1 Yates Farm _____
Hought et al Company _____
NORTH

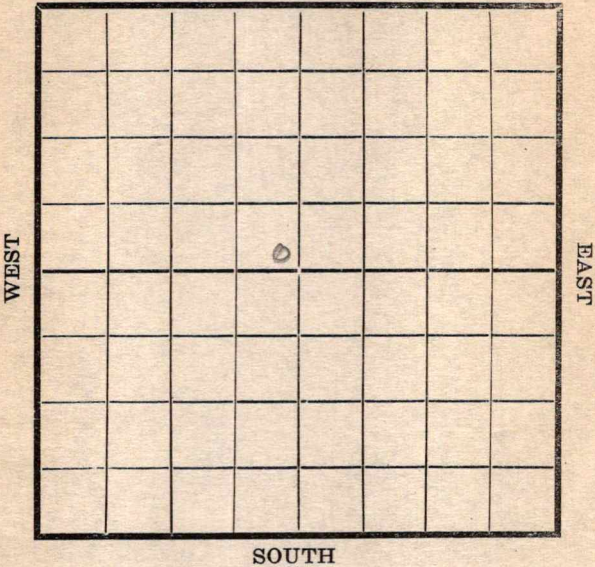


	RECORD
Location _____	Cased _____ in. _____ Ft.
Rig Up _____	Sand _____
Drilling and remarks	Gas _____
<u>Rigging</u>	Oil _____
	Total Depth _____
	PRODUCTION
	1st 24 hrs. Nat. _____
	1st 24 hrs. after shot _____
	Gas _____ Cu. Ft.
	Dry Hole _____
	Abandoned _____

Date 12/19, 1917 Conley Scout _____

Map No. _____ Sec. 1 Twp. 28 R. 5Well No. 1 Yates Farm _____
Hoyt et al Company _____

NORTH

WEST

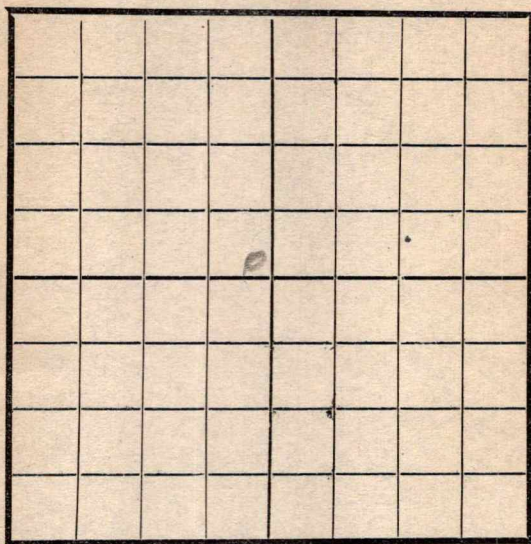

EAST

SOUTH

Location _____

Rig Up _____

Drilling and remarks

200

RECORD

Cased _____ in. _____ Ft.

Sand _____

Gas _____

Oil _____

Total Depth _____

PRODUCTION

1st 24 hrs. Nat. _____

1st 24 hrs. after shot _____

Gas _____ Cu. Ft.

Dry Hole _____

Abandoned _____


Date

1/2, 1918 Condy Scout

Map No. _____ Sec. 1 Twp. 28 R. 5Well No. 1 yater _____ Farm _____Boyle et al _____ Company _____

NORTH

WEST

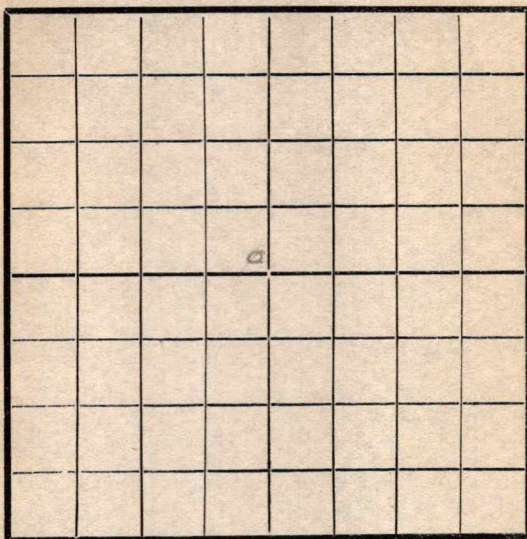

EAST

SOUTH

Location _____

Rig Up _____

Drilling and remarks

490

RECORD

Cased _____ in. _____ Ft.

Sand _____

Gas _____

Oil _____

Total Depth _____

PRODUCTION

1st 24 hrs. Nat. _____

1st 24 hrs. after shot _____

Gas _____ Cu. Ft.

Dry Hole _____

Abandoned _____


Date

1/9, 1918 S. Canady _____ Scout _____

Map No. _____ Sec. 1 Twp. 28 R. 5Well No. 1 Yates Farm _____J. Hoyt et al Company _____

NORTH

WEST

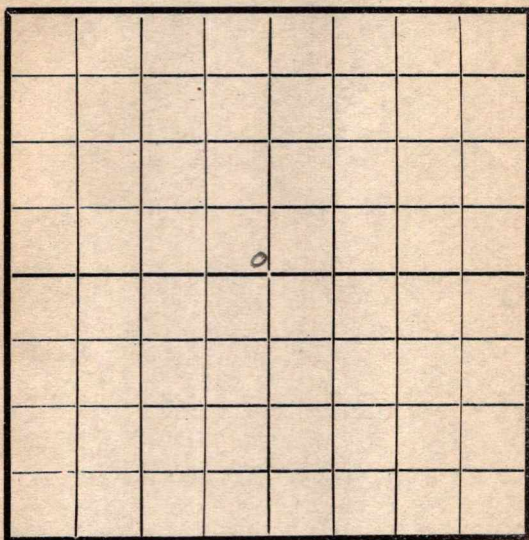

EAST

SOUTH

Location _____

Rig Up _____

Drilling and remarks

22500

RECORD

Cased _____ in. _____ Ft.

Sand _____

Gas _____

Oil _____

Total Depth _____

PRODUCTION

1st 24 hrs. Nat. _____

1st 24 hrs. after shot _____

Gas _____ Cu. Ft.

Dry Hole _____

Abandoned _____


Date

1/16, 1918 C. Condy Scout

Map No. _____ Sec. 1 Twp. 38 R. 5Well No. 1 Yates Farm __________Wright et al Company

NORTH

WEST

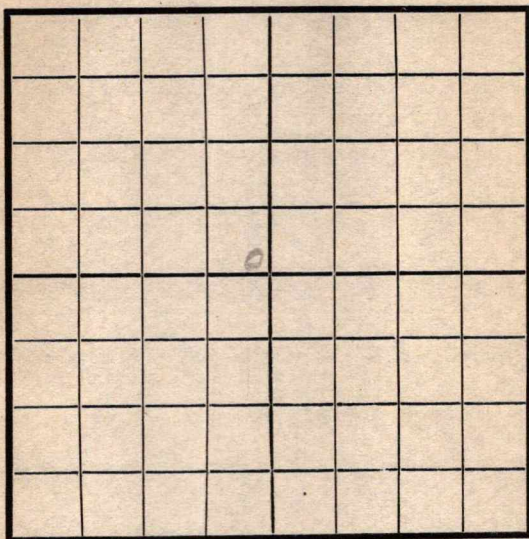

EAST

SOUTH

Location _____

Rig Up _____

Drilling and remarks

800

RECORD

Cased _____ in. _____ Ft.

Sand _____

Gas _____

Oil _____

Total Depth _____

PRODUCTION

1st 24 hrs. Nat. _____

1st 24 hrs. after shot _____

Gas _____ Cu. Ft.

Dry Hole _____

Abandoned _____


Date

1/23, 1918 J. Condy Scout

Map No. _____ Sec. 1 Twp. 28 R. 5Well No. 1 Yates Farm
Hoyt et al Company

NORTH

WEST

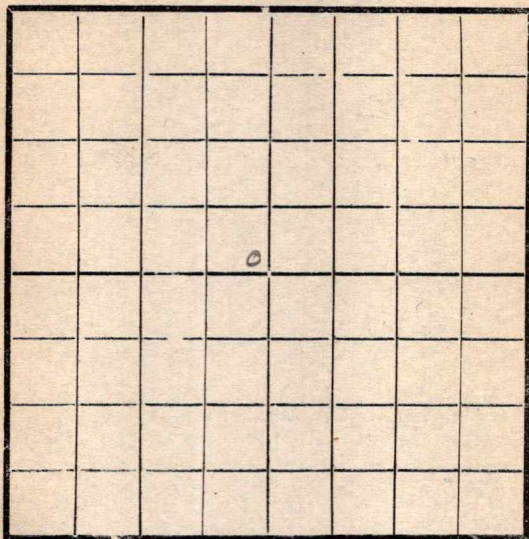

EAST

SOUTH

Location _____

Rig Up _____

Drilling and remarks

950

RECORD

Cased _____ in. _____ Ft.

Sand _____

Gas _____

Oil _____

Total Depth _____

PRODUCTION

1st 24 hrs. Nat. _____

1st 24 hrs. after shot _____

Gas _____ Cu. Ft.

Dry Hole _____

Abandoned _____

Date


1/30, 1918 Cand Scout

Map No. _____ Sec. 1 Twp. 28 R. 5

Well No. 1 Yates Farm _____
Hoyt et al Company _____

NORTH

WEST

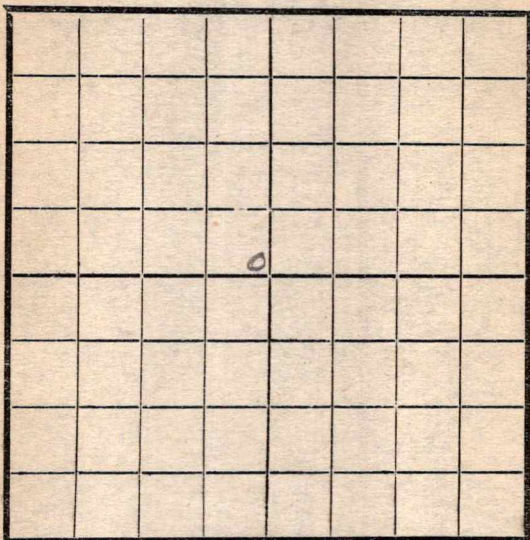

EAST

SOUTH

Location _____

Rig Up _____

Drilling and remarks

22 950

RECORD

Cased _____ in. _____ Ft.

Sand _____

Gas _____

Oil _____

Total Depth _____

PRODUCTION

1st 24 hrs. Nat. _____

1st 24 hrs. after shot _____

Gas _____ Cu. Ft.

Dry Hole _____

Abandoned _____


Date

26, 1918 Corday Scout

Map No. _____ Sec. 1 Twp. 28 R. 5Well No. 1 Yates Farm
Hoyt et al Company

NORTH

WEST

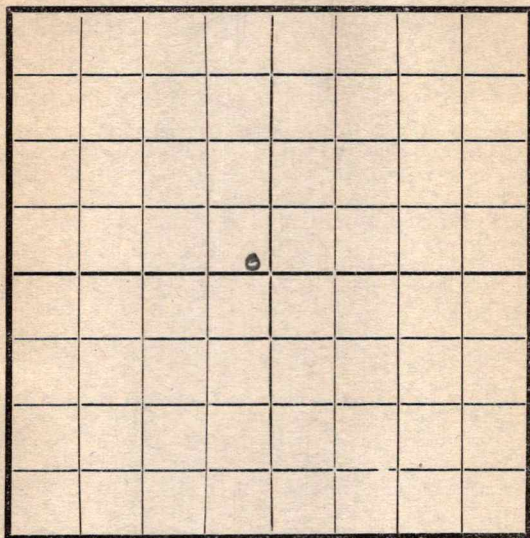

EAST

SOUTH

Location _____

Rig Up _____

Drilling and remarks

1600

RECORD

Cased _____ in. _____ Ft.

Sand _____

Gas _____

Oil _____

Total Depth _____

PRODUCTION

1st 24 hrs. Nat. _____

1st 24 hrs. after shot _____

Gas _____ Cu. Ft.

Dry Hole _____

Abandoned _____


Date

2/13, 1918 Candey Scout

Map No. _____ Sec. 1 Twp. 38 R. 5

Well No. 1 Yates Farm _____
Yates Company _____
 NORTH

WEST

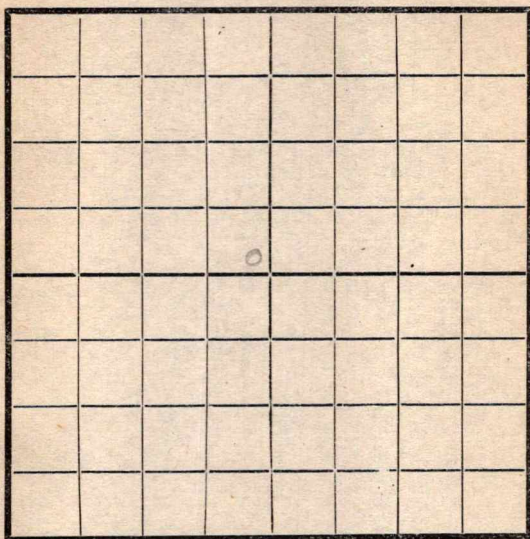


EAST

SOUTH

RECORD	
Location _____	Cased _____ in. _____ Ft.
Rig Up _____	Sand _____
Drilling and remarks	Gas _____
<u>221600</u>	Oil _____
	Total Depth _____
	PRODUCTION
	1st 24 hrs. Nat. _____
	1st 24 hrs. after shot _____
	Gas _____ Cu. Ft.
	Dry Hole _____
	Abandoned _____

Date 2/20, 1918 Scout J. C. Cady

Map No. _____ Sec. 1 Twp. 28 R. 5
 Well No. 1 Yates Farm _____
Hoght et al Company _____
 NORTH

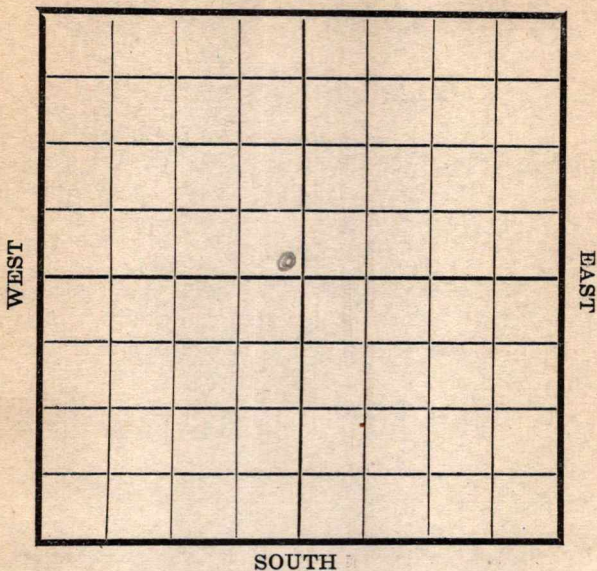

Location _____
 Rig Up _____
 Drilling and remarks

2060

RECORD

Cased _____ in. _____ Ft.
 Sand _____
 Gas _____
 Oil _____
 Total Depth _____

PRODUCTION

1st 24 hrs. Nat. _____
 1st 24 hrs. after shot _____
 Gas _____ Cu. Ft.
 Dry Hole _____
 Abandoned _____

Date

2/27, 1918 Candiff Scout

Map No. _____ Sec. 1 Twp. 28 R. 5Well No. 1 gates Farm __________Haystack Company

NORTH

WEST

EAST

SOUTH

Location _____

Rig Up _____

Drilling and remarks

RECORD

Cased _____ in _____ Ft.

Sand _____

Gas _____

Oil _____

Total Depth _____

PRODUCTION

1st 24 hrs. Nat. _____

1st 24 hrs. after shot _____

Gas _____ Cu. Ft.

Dry Hole _____

Abandoned _____


Date

3/6, 1918 S. C. C. C. Scout

Map No. K11 Sec. 1 Twp. 28 R. 5Well No. 1 Yates FarmCompany Kay et al

NORTH

WEST

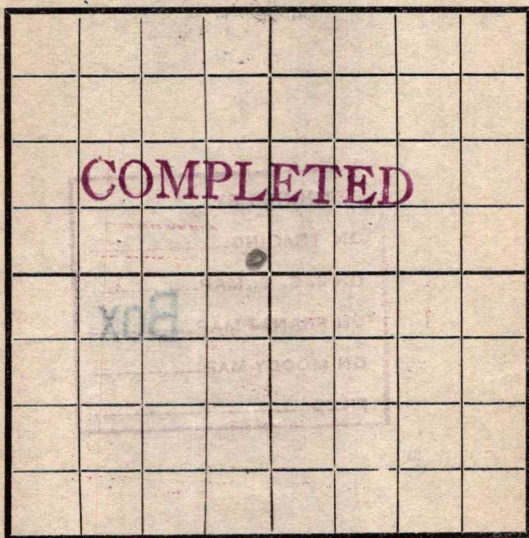

EAST

SOUTH

Location -----

Rig Up -----

Drilling and remarks

Drilled to 2735
 Plugged back to
 2732; shot with
 40 gts. Has
 2000' oil in hole
 and 500' water
 Probably good for

RECORD

Cased ----- in. ----- Ft.

Sand 2705-2732

Gas -----

Oil -----

Total Depth -----

PRODUCTION

1st 24 hrs. Nat. -----

1st 24 hrs. after shot -----

Gas ----- Cu. Ft.

Dry Hole -----

Abandoned -----

Date

80 Bbls - estimate3/13

191

8 Condor

Scout