
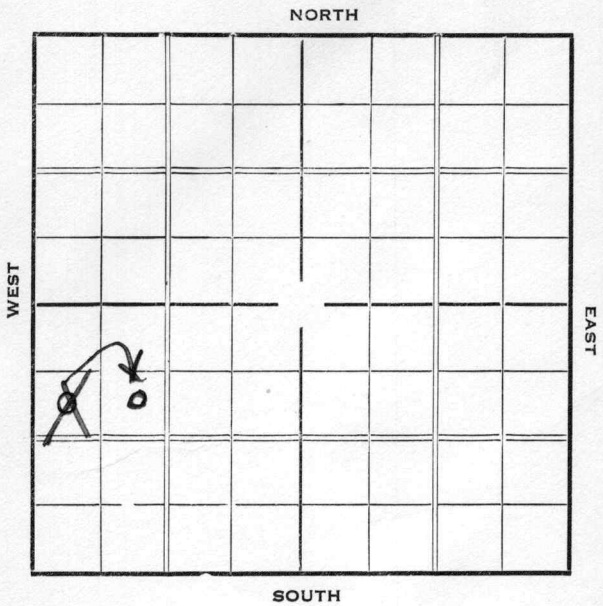


Section 2 Township 23 Range 14-E

Well Number 2 Hannan

Company Hinze et al

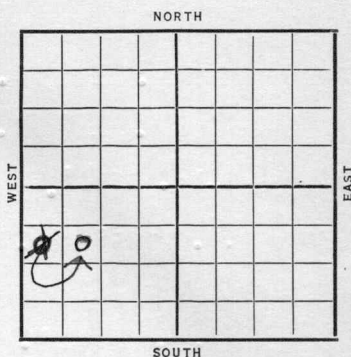

Sec. 12 Twp. 23 R. 14-EWell No. #2 Hannan Farm  
Hinze et al Company990 Ft. from N. Line       Ft. from S. Line       Ft. from E. Line990  
~~880~~ Ft. from W. Line

| Date | REPORT                   |
|------|--------------------------|
| 1937 |                          |
| 2/17 | Rigging up machine.      |
| 2/26 | " " "                    |
| 3/4  | " " "                    |
| 3/11 | " " "                    |
| 3/18 | " " "                    |
| 3/25 | Spud                     |
| 4/2  | Shut Down                |
| 4/8  | " "                      |
| 4/16 | " "                      |
| 4/23 | Spud & SD                |
| 4/30 | Drlg. 640'.              |
| 5/7  | SD 750'.                 |
| 5/14 | 8" @ 716'. Drlg. 950'.   |
| 5/21 | 6" @ 1000'. C.O.         |
| 5/28 | Drlg. 1255'.             |
| 6/4  | " "                      |
| 6/11 | " "                      |
| 6/19 | Drlg. 1255'.             |
| 6/25 | " "                      |
| 7/2  | 5" @ 1353'. Drlg. 1360'. |
| 7/9  | " " " "                  |
|      |                          |

OVER

1937

7/16 Drlg. 1404'.

7/23 Drlg. 1445'.

7/30 Drlg. 1510'.

8/6 T.D. 1555' fsg.

8/13 " "

8/20 T.D. 1571'. SD for repairs.

8/28 Miss. 1574'. T.D. 1578'.

U. R. 5".

9/3 " "

9/10 " "

9/17 " "

9/24 " "

10/2 " "

10/8 Drlg. 1591'.

10/15 Drlg. 1591'.

10/20 5" @ 1574'.

Sil. 1691'.

T.D. 1717'.

1 B.W.

No show oil.

ABANDONED

Map No. 17 Sec. 12 Twp. 23 R. 14E

Well No. 2. Hannan

Hinge & Co Company

Contractor

SECTION PLAT

|  |  |  |  |
|--|--|--|--|
|  |  |  |  |
|  |  |  |  |
|  |  |  |  |
|  |  |  |  |

990 Ft. from N. Line

\_\_\_\_\_ Ft. from S. Line

\_\_\_\_\_ Ft. from E. Line

330 Ft. from W. Line

FIRST REPORT

RECORD

Location \_\_\_\_\_

Cased \_\_\_\_\_ in., \_\_\_\_\_ ft.

Rig up \_\_\_\_\_

Sand \_\_\_\_\_

Drilling and Remarks:

Gas \_\_\_\_\_

Oil \_\_\_\_\_

Total Depth \_\_\_\_\_

Rigging up Machine

PRODUCTION

1st 24 hrs. Nat. \_\_\_\_\_

1st 24 hrs. after shot \_\_\_\_\_

Gas \_\_\_\_\_ Cu. Ft.

Dry Hole \_\_\_\_\_

Abandoned \_\_\_\_\_

Date

FEB 17 1937 19

S. J. LEWIS

Scout

Map No. 17 Sec. 12 Twp. 23 R. 14EWell No. 2. HannanHinge & Co. Company

Contractor

## SECTION PLAT

|  |  |  |  |
|--|--|--|--|
|  |  |  |  |
|  |  |  |  |
|  |  |  |  |
|  |  |  |  |

990 Ft. from N. Line

\_\_\_\_\_ Ft. from S. Line

\_\_\_\_\_ Ft. from E. Line

990 Ft. from W. Line

CORRECTION

Location \_\_\_\_\_

Rig up \_\_\_\_\_

Drilling and Remarks:

*Reported*  
*S.W. NW. SE.*

## RECORD

Cased \_\_\_\_\_ in., \_\_\_\_\_ ft.

Sand \_\_\_\_\_

Gas \_\_\_\_\_

Oil \_\_\_\_\_

Total Depth \_\_\_\_\_

## PRODUCTION

1st 24 hrs. Nat. \_\_\_\_\_

1st 24 hrs. after shot \_\_\_\_\_

Gas \_\_\_\_\_ Cu. Ft.

Dry Hole \_\_\_\_\_

Abandoned \_\_\_\_\_

Date

FEB 24 1937

19

S. J. LEWIS Scout

KANSAS

Coffey

Map No. 17 Sec. 12 Twp. 23 R. 14EWell No. 2 HannanHinze etal Company

Contractor

ABANDONED

SE NW SW

## SECTION PLAT

|   |  |  |  |
|---|--|--|--|
|   |  |  |  |
|   |  |  |  |
| 0 |  |  |  |
|   |  |  |  |

990 Ft. from N. Line

Ft. from S. Line

Ft. from E. Line

990 Ft. from W. Line

Location \_\_\_\_\_

Rig up \_\_\_\_\_

Drilling and Remarks:

1 Bw  
No show oil

D &amp; A

## RECORD

Cased 5 in., 1574 ft.Sand 511 1691

Gas \_\_\_\_\_

Oil \_\_\_\_\_

Total Depth 1717

## PRODUCTION

1st 24 hrs. Nat. \_\_\_\_\_

1st 24 hrs. after shot \_\_\_\_\_

Gas \_\_\_\_\_ Cu. Ft.

Dry Hole \_\_\_\_\_

Abandoned \_\_\_\_\_

Date

OCT 20 1937

19

H. D. Hatfield Scout