

Butler


24

34

Map No. KANSAS Sec. 34 Twp. 27 R. 3E

Well No. 1 Davis Farm

Richman, Beigh & Sanford Company

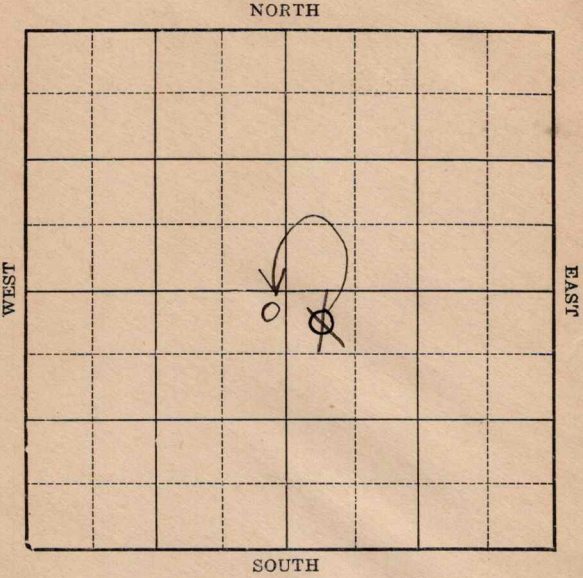

Location _____
Drilling Remarks _____

Rig Up _____
Drilling Remarks _____

RECORD

Cased _____ in. _____ ft.
Sand _____
Gas _____
Oil _____
Total Depth _____

PRODUCTION

1st 24 hrs. Nat. _____
1st 24 hrs. after shot _____
Gas _____ cu. ft.
Dry Hole _____
Abandoned _____

Butler

Map No. KANSAS Sec. 24 Twp 27 R. 3E

Well No. 1 Davis Farm


Richman, Beigh & Sanford Company

330 Ft. from N. Line

 Ft. from S. Line

20 Ft. from E. Line

330 Ft. from W. Line

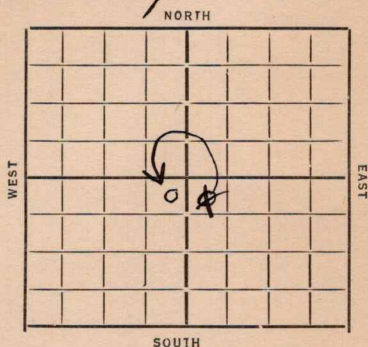

Date 1934

REPORT

2/7 Location
2/17 — 2/23 — 2/1 — 3/8 —
3/15 — ~~3/22~~ —
3/22 Rig
3/29 — 4/5 —
4/12 Moving in
4/19 Spud
4/26 dly 350 15" 143
5/3 2D 800
5/10 2D 1185
5/18 dly 1880 12" 939 10" 1640
5/25 3.0. 2278-85 247 26 2335-60
dly 2455
5/31 2D 2812
6/7 2 1/2 x 2975 TD 3011
22 1/2 Bbls oil 24 hrs.
6/14 — 6/21 — 6/28 —
7/4 — 7/12 — 7/19 —
7/26 TD 3012 140 gts CO.
8/1 Wilcox 3011 TD 3012
140 gt shot 10 Bbls.

COMPLETED

Map No. 12 Sec. 34 Twp. 27 R. 3E

Well No. 1-Davis

Reichman, Beigle & Sanford Company

Contractor

FIRST REPORTS

SECTION PLAT

		0	

330 Ft. from N. Line

..... Ft. from S. Line

..... Ft. from E. Line

330 Ft. from W. Line

Location ☒

Rig up

Drilling and Remarks:

RECORD

Cased.....in.,ft.

Sand

Gas

Oil

Total Depth

PRODUCTION

1st 24 hrs. Nat.

1st 24 hrs. after shot

Gas.....Cu. Ft.

Dry Hole

Abandoned

Date

2-7-34 192 O. Manschreck Scout

Map No. 12 Sec. 24 Twp. 27 R. 3EWell No. 1 - Bausinger
Richman, Keigle + Sanford Company

Contractor

CORRECTION

SECTION PLAT

		0	

330 Ft. from N. Line

Ft. from S. Line

Ft. from E. Line

330 Ft. from W. Line**CORRECTION**

RECORD

Location

Cased.....in.,ft.

Rig up

Sand

Drilling and Remarks:

Gas

Oil

Total Depth

PRODUCTION

1st 24 hrs. Nat.

1st 24 hrs. after shot

Gas.....Cu. Ft.

Dry Hole

Abandoned

Date

2-14-34 192 O. Mann Scoutformerly
reported in
section 34

Map No. 12 Sec. 24 Twp. 27 R. 3E

Well No. 1- Bausinger

Richman, Reigle & Sanford Company

Contractor

CORRECTION

330 Ft. from N. Line


..... Ft. from S. Line

20 Ft. from E. Line

..... Ft. from W. Line

CORRECTION

SECTION PLAT

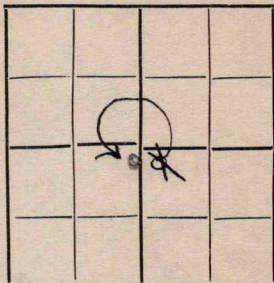

TWIN WELL

Location.....

Rig up.....

Drilling and Remarks:

RECORD

Cased.....in.,ft.

Sand.....

Gas.....

Oil.....

Total Depth.....

PRODUCTION

1st 24 hrs. Nat.....

1st 24 hrs. after shot.....

Gas.....Cu. Ft.

Dry Hole.....

Abandoned.....

Date

3-7-34 192..... O. Mannes Scout

*formerly reported
330 n.
330 w.
A & quarter*

Map No. 12 Sec. 27 Twp. 27 R. 3EWell No. 1- BausingerRichman et al Company

Contractor

COMPLETED

SECTION PLAT

	0		

330 Ft. from N. Line

_____ Ft. from S. Line

20 Ft. from E. Line

_____ Ft. from W. Line

Location _____

Rig up _____

Drilling and Remarks:

140 ft shot10 bbls

RECORD

Cased _____ in., _____ ft.

Sand Wilcox 3011

Gas _____

Oil _____

Total Depth 3012

PRODUCTION

1st 24 hrs. Nat. _____

1st 24 hrs. after shot _____

Gas _____ Cu. Ft.

Dry Hole _____

Abandoned _____

Date

8-1-37 19

ORVAL MANNSCHRECK Scout