

WEST

EAST

0

COMPLETED

FIRST REPORT

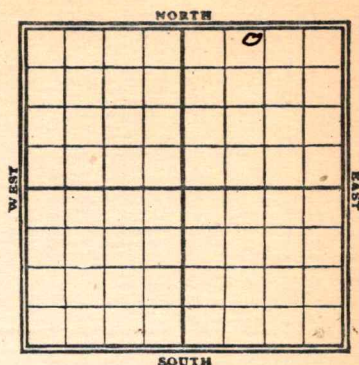
SOUTH

Abandoned _ _ _ _ _

Map No. T. 11 Sec. 18 Twp. 29 R. 4Well No. P. Kollenberg Farm
Md. Kans. Oil Company200 Ft. from N. Line

_____ Ft. from S. Line

_____ Ft. from E. Line

1120 Ft from W. Line

Date

REPORT

P/1

Dly @ 600'

17

1860

1921

1/27

1920 - 30 - 20 bbl.

COMPLETED

Map No. K11 Sec. 18 Twp. 29 R. 4Well No. 9 KollenbergMid-Kansas Oil Company

Contractor

SECTION PLAT

200 Ft. from N. Line

Ft. from S. Line

Ft. from E. Line

1120 Ft. from W. Line

FIRST REPORT

Location

Rig up

Drilling and Remarks:

RECORD

Cased _____ in., _____ ft.

Sand _____

Gas _____

Oil _____

Total Depth _____

PRODUCTION

1st 24 hrs. Nat. _____

1st 24 hrs. after shot _____

Gas _____ Cu. Ft.

Dry Hole _____

Abandoned _____

Date

9/1 19120

Pyle

Scout

Map No. K 11 Sec. 18 Twp. 29 R. 4Well No. 9 KnollenbergMid-Kansas Company

Contractor

SECTION PLAT

		0	

COMPLETED

200 Ft. from N. Line

Ft. from S. Line

Ft. from E. Line

1170 Ft. from W. Line

Location

Rig up

Drilling and Remarks:

RECORD

Cased _____ in., _____ ft.

Sand 1920-30

Gas _____

Oil _____

Total Depth _____

PRODUCTION

1st 24 hrs. Nat. 20 bbls

1st 24 hrs. after shot _____

Gas _____ Cu. Ft.

Dry Hole _____

Abandoned _____

Date

1/27 1921KBP Scout