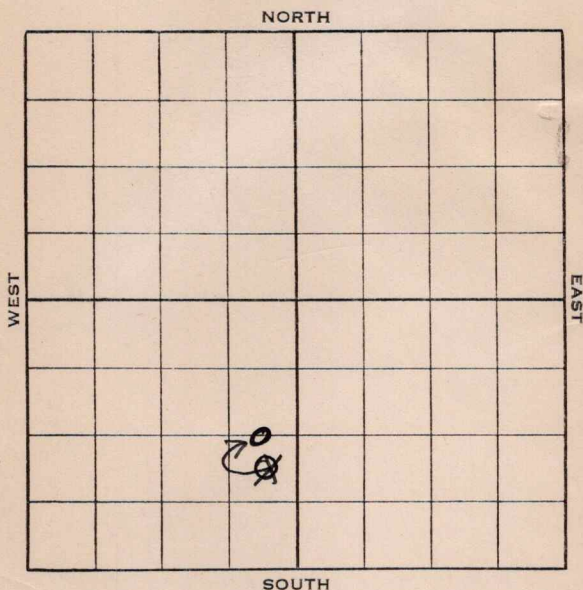



KANSAS

Butler

Section 24 Township 27 Range 3-EWell No. #2 X BausingerCompany Richmond Drilling

Sec. 24 Twp. 27 R. 3-EWell No. ~~14~~ Bausinger #2 FarmRichmond Drlg. Company Ft. from N. Line1320
~~990~~ Ft. from S. Line330 Ft. from E. Line Ft. from W. Line

Elev. 1334

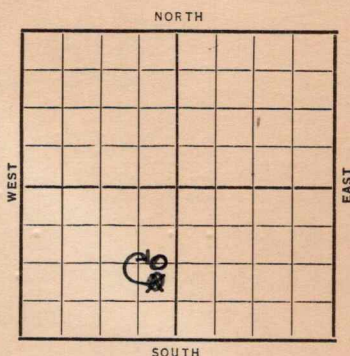

Date

REPORT

1938

3/9 15" @ 156'. 12" @ 193'.

Fishing 938'.

3/18 Drlg. 945'.

3/25 10" @ 1598'. Drlg. 1640'.

4/1 Drlg. 1985'.

4/8 K.C. 2278'. S.O. 2300'.

8" @ 2367'. H.F.W. 2335'.

Drlg. 2680'.

4/15 Miss. L. 2743'. 6" @ 2759'.

Drlg. 2827'.

4/22 Viola 2988'. Wilcox 3051'.

T.D. 3056'. Shot 80 qts.

4/29 " " " " "

5/6 " " " " "

5/12 Est. 25 oil per day.

5/20 " " " "

OVER

756834

1938

5/25

6" @ 3051' ?

Wilcox 3051'.

T.D. 3056'.

Shot 80 qts.

10 oil & 7 water.

COMPLETED

Butler

KANSAS

Map No. 12 Sec. 24 Twp. 27 R. 3EWell No. 1 BausingerRichmond Drilling Company

Contractor

FIRST REPORT

NE SE SW

 Ft. from N. Line990 Ft. from S. Line330 Ft. from E. Line Ft. from W. Line

SECTION PLAT

	0		

Location Rig up

Drilling and Remarks:

15"- 15612"- 193Fishing 938

RECORD

Cased in., ft.Sand Gas Oil Total Depth

PRODUCTION

1st 24 hrs. Nat. 1st 24 hrs. after shot Gas Cu. Ft.Dry Hole Abandoned

Date

MAR 9 - 1938 19

H. D. Hatfield

Scout

Butler

KANSAS

Map No. 12 Sec. 24 Twp. 27 R. 3EWell No. 2 BausingerRichmond Drlg.

Company

Contractor

COMPLETED

CELSW

~~NE SE SW~~

Ft. from N. Line

1320 Ft. from S. Line330 Ft. from E. Line

Ft. from W. Line

SECTION PLAT

See correction Ticket Attached			

Location

Rig up

Drilling and Remarks:

Shot 80 gts

10 oil

7 wtr

RECORD

Cased 6 in., 3051 ft.Sand Wilcox 3051

Gas

Oil

Total Depth 3056

PRODUCTION

1st 24 hrs. Nat.

1st 24 hrs. after shot

Gas Cu. Ft.

Dry Hole

Abandoned

Date

MAY 25 1938

19

H. D. Hatfield

Scout

Butler KANSAS

Map No. _____ Sec. 24 Twp. 27 R. 3^EWell No. 2 - BausingerRichmond Drilling Company

Contractor

SECTION PLAT


CEL SW

CORRECTION

_____ Ft. from N. Line

1320 Ft. from S. Line330 Ft. from E. Line

_____ Ft. from W. Line

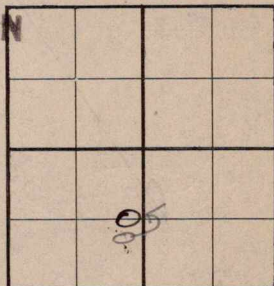

Location _____

RECORD

Cased _____ in., _____ ft.

Rig up _____

Sand _____

Drilling and Remarks:

Gas _____

First Reported 25

Oil _____

NE SESW - Corrected

Total Depth _____

To CEL SW and

PRODUCTION

1st 24 hrs. Nat. _____

Number changed

1st 24 hrs. after shot _____

From #1 - To #2

Gas _____ Cu. Ft.

Dry Hole _____

Abandoned _____

Date

MAY 25 1938

E. D. Hatfield

19

Scout