


Map No. **KANSAS** Sec. 24 Twp. 27 R. 3E

Well No. T-Sharon Farm
Maddin Pet Company

NORTH *(Bessu Sharon)*

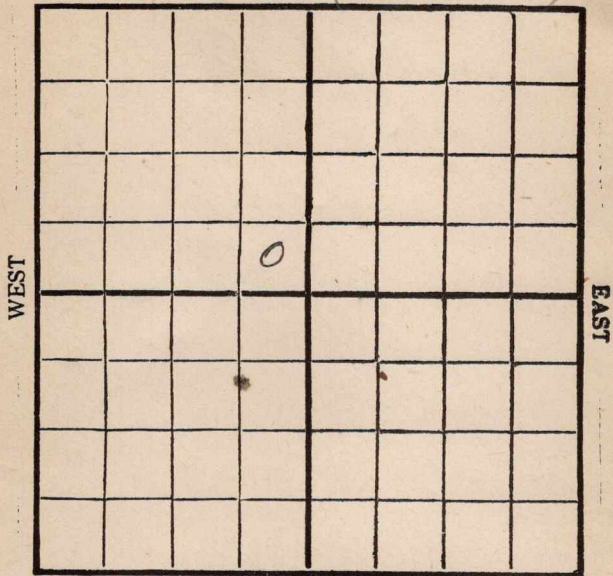

SOUTH

Location _____

Drilling Remarks

Rig Up _____

Drilling Remarks

RECORD

Cased _____ in. _____ ft.

Sand _____

Gas _____

Oil _____

Total Depth _____

PRODUCTION

1st 24 hrs. Nat. _____

1st 24 hrs. after shot _____


Gas _____ cu. ft. _____

Dry Hole _____

Abandoned _____

Map No. **KANSAS** Sec. 24 Twp. 27 R. 3^E
 Well No. 1 - Shabron Farm
Aladdin Ket Company

_____ Ft. from N. Line
330 Ft. from S. Line
330 Ft. from E. Line
 _____ Ft. from W. Line

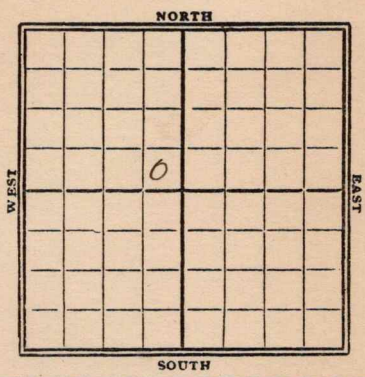

1929

Date	REPORT
8/14	Location
8/21	Rig
8/28	Spdy
9/14	Drlg 925'
9/11	10" @ 1650'
9/18	Drly 2430'
9/25	sand 3003-10'
	filled up 1100' in 2 hrs.
	and 3012-16 T.D.
	No increase in oil
10/2	sand 3003-20'
	pump 60 bbl 1 st 24 hrs.
	" 30 " 2 nd " "
	" 17 " 12 hours
	shows some water
	Drly 3052'
10/9	T.D. 3078'
	P.B. to 3071'
10/16	T.D. 3078' P.B. to 3068 1/2'
	sand 3003-20'
	shot 70 gts
	60 bbls oil

Map No. **KANSAS** Sec. 24 Twp. 27 R. 3E

Well No. 1 Sharron

Blacklin Pet Company

Contractor

FIRST REPORTS

SECTION PLAT

_____ Ft. from N. Line

330 Ft. from S. Line

330 Ft. from E. Line

_____ Ft. from W. Line

Location ✓

Rig up _____

Drilling and Remarks:

RECORD

Cased _____ in., _____ ft.

Sand _____

Gas _____

Oil _____

Total Depth _____

PRODUCTION

1st 24 hrs. Nat. _____

1st 24 hrs. after shot _____

Gas _____ Cu. Ft.

Dry Hole _____

Abandoned _____

Date

AUG 14 1929

CHAS. L. SHERWOOD

19

Scout

Butler

Map No. **KANSAS** Sec. 24 Twp. 27 R. 3^E

Well No. 1 Sharrow

Aladdin Fuel Co Company

Contractor

COMPLETE

SECTION PLAT

.....Ft. from N. Line

330 Ft. from S. Line

330 Ft. from E. Line

.....Ft. from W. Line

	o		

Location.....

Rig up.....

Drilling and Remarks:

P.B. to 3068 1/4

70/100 Bls.

RECORD

Cased 3 in. ft.

Sand 2003-3020

Gas.....

Oil.....

Total Depth 2078

PRODUCTION

1st 24 hrs. Nat.....

1st 24 hrs. after shot.....

Gas.....Cu. Ft.

Dry Hole.....

Abandoned.....

Date

OCT 16 1929

CHAS. L. SHERWOOD

.....192.....Scout