

Map No. KANSAS Sec. 2 Twp. 25<sup>S</sup> 4<sup>E</sup>

Well No. 1-2 Farmer Farm Assn  
Butler Co - Kansas Drilling Company

NORTH

				0			

WEST

EAST

SOUTH

Location.....

Drilling Remarks

.....

.....

RECORD

Cased..... in..... ft.

Sand.....

Gas.....

Oil.....

Total Depth.....

Rig Up.....

Drilling Remarks

.....

.....

PRODUCTION

1st 24 hrs. Nat.....

1st 24 hrs. after shot.....

Gas..... cu. ft.....

Dry Hole.....

Abandoned.....

Map No. .... Sec. .... Twp. .... R. ....

Well No. .... Farm


..... Company

..... Ft. from N. Line

..... Ft. from S. Line

..... Ft. from E. Line

..... Ft. from W. Line

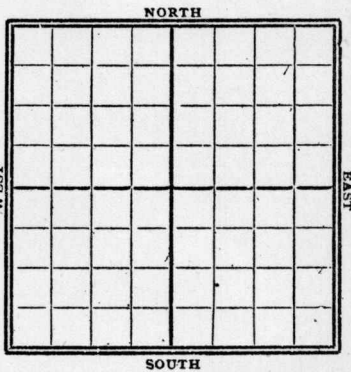

~~7928~~ 1923

Date

REPORT

*Gypsy Records*

11/29

*Abd T.D. 2815'*

MAP NO. KANSAS SEC. 2 TWP. 25S R. 1E

WELL NO. 1 3 armer

Butler Co. Lou Holyday COMPANY

CONTRACTOR

SECTION PLAT

ABANDONED

\_\_\_\_\_ FT. FROM N. LINE

\_\_\_\_\_ FT. FROM S. LINE

\_\_\_\_\_ FT. FROM E. LINE

\_\_\_\_\_ FT. FROM W. LINE

		0	

*no record*

LOCATION \_\_\_\_\_

RIG UP \_\_\_\_\_

DRILLING AND REMARKS:

*OK*

RECORD

CASED \_\_\_\_\_ IN. \_\_\_\_\_ FT.

SAND \_\_\_\_\_

GAS \_\_\_\_\_

OIL \_\_\_\_\_

TOTAL DEPTH 2815

PRODUCTION

1ST 24 HRS. NAT. \_\_\_\_\_

1ST 24 HRS. AFTER SHOT \_\_\_\_\_

GAS \_\_\_\_\_ CU. FT.

DRY HOLE

ABANDONED

DATE Mar 29 31 192

SCOUT