

Map No. 11 Sec. 5 Twp. 25 R. 4

Well No. 1- Hitch Farm
Wickensville Company

NORTH

WEST

EAST

SOUTH

Location _____

Drilling Remarks:

Rig up _____

Drilling Remarks:

RECORD

Cased _____ in. _____ ft.

Sand _____

Gas _____

Oil _____

Total Depth_____

PRODUCTION

1st 24 hrs Nat. _____

1st 24 hrs. after shot_____

Gas _____ cu. ft.

Dry Hole_____


Abandoned _____

Map No. K Sec. 5 Twp. 25 R. 4 EWell No. 1 Hitch FarmVickers Shale Company200 Ft. from N. Line

_____ Ft. from S. Line

200 Ft. from E. Line

_____ Ft. from W. Line

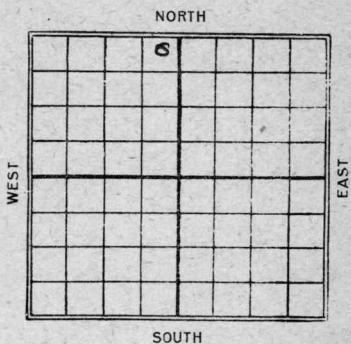

Date

REPORT

5/12 Location7/16 ~~6578~~ 8 1/4 sec 2110'9/9 2720-32-70. 273330 Blk hat

14 KANSAS Map No. _____ Sec. 5 Twp. 25 R. 4E

Well No. #1 Fitch

 _____ Company

 _____ Contractor

FIRST REPORT

SECTION PLAT

200 _____ Ft. from N. Line

_____ Ft. from S. Line

200 _____ Ft. from E. Line

_____ Ft. from W. Line

	0		

Location _____

Rig up _____

Drilling and Remarks:

RECORD

Cased _____ in., _____ ft.

Sand _____

Gas _____

Oil _____

Total Depth _____

PRODUCTION

1st 24 hrs. Nat. _____

1st 24 hrs. after shot _____

Gas _____ Cu. Ft.

Dry Hole _____

Abandoned _____

Date

M. A. BENEAR

MAY 22 1924

192

Scout

14 **KANSAS** Map No. _____ Sec. 5 Twp. 25 R. 4 E.

Well No. 1 Fitch _____

Vickum et al Company _____

Contractor _____

COMPLETED SECTION PLAT

200 Ft. from N. Line

_____ Ft. from S. Line

200 Ft. from E. Line

_____ Ft. from W. Line

	0		

Location _____

Rig up _____

Drilling and Remarks:

sand 2720-32

S.D. 2733

30 lbs Nat.

RECORD

Cased _____ in., _____ ft.

Sand _____

Gas _____

Oil _____

Total Depth _____

PRODUCTION

1st 24 hrs. Nat. _____

1st 24 hrs. after shot _____

Gas _____ Cu. Ft.

Dry Hole _____

Abandoned _____

Date

SEP

1924

M. A. BENEAR

192

Scout