Form 51—5M—3-26—22544

Map No. KANSAS Sec. 15 Twp. 17 R. 4

Well No. 1- Costetter Farm

Cress etal Company

16

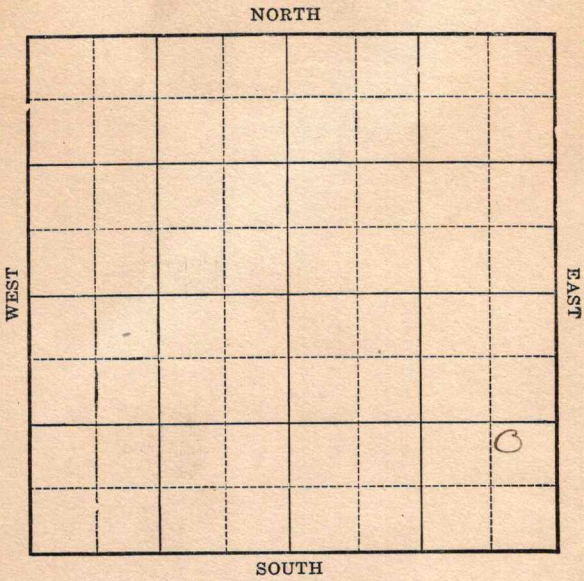

Location

Drilling Remarks

Rig Up

Drilling Remarks

RECORD

Cased in. ft.

Sand

Gas

Oil

Total Depth

PRODUCTION

1st 24 hrs. Nat.

1st 24 hrs. after shot

Gas cu. ft.

Dry Hole

Abandoned

Form 252A—5M—11-25—20913

Map No. KANSAS Sec. 15 Twp. 17 R. 4

Well No. 1- Costeter Farm

Cress etal Company

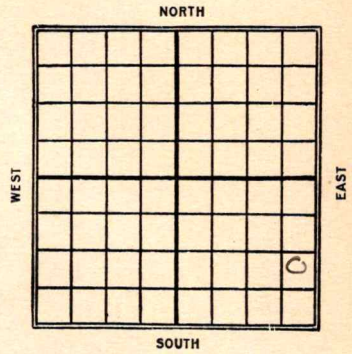

____ Ft. from N. Line

1038 Ft. from S. Line

434 Ft. from E. Line

____ Ft. from W. Line

1938

Date	REPORT
1/11	Cellar
1/18	—
1/26	Timbers
2/2	—
2/9	—
2/16	—
2/23	—
3/1	Abandoned loc

Form 26—1M Bks.—3-23—11959. Marion

KANSAS.

Map No. 320 2nd Sec. 15 Twp. 17 R. 4

Well No. 1 Costeten

Oless et al Company

Contractor

FIRST REPORTS

SECTION PLAT

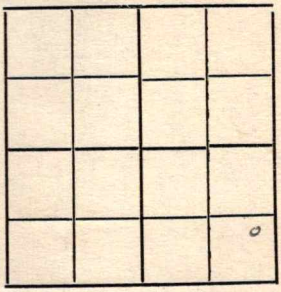

---Ft. from N. Line

1038 Ft. from S. Line

434 Ft. from E. Line

---Ft. from W. Line

Location

Rig up

Drilling and Remarks:

Cellar

RECORD

Cased ---in., --- ft.

Sand

Gas

Oil

Total Depth

PRODUCTION

1st 24 hrs. Nat.

1st 24 hrs. after shot

Gas ---Cu. Ft.

Dry Hole

Abandoned

Date

JAN 11 1928

---192---

CHAS. L. SHERWOOD

Scout

Form 26—1M Bks.—3-23—11959.

Marion

KANSAS

Map No. ---------- Sec. 15 Twp. 17 R. 4

Well No. 1 Costeter

Cress et al

---------- Company

---------- Contractor

COMPLETED

---------Ft. from N. Line

1038 Ft. from S. Line

434 Ft. from E. Line

---------Ft. from W. Line

ABANDONED

SECTION PLAT

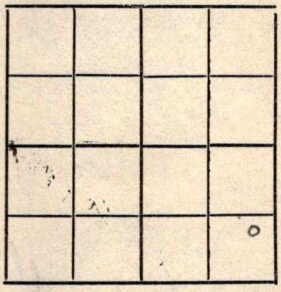

Location ----------

Rig up ----------

Drilling and Remarks:

location

DD

RECORD

Cased ---------in., ------- ft.

Sand ----------

Gas ----------

Oil ----------

Total Depth ----------

PRODUCTION

1st 24 hrs. Nat. ----------

1st 24 hrs. after shot -------

Gas ----------Cu. Ft.

Dry Hole ----------

Abandoned ---------- location

Date

MAR 1 1928 CHAS. L. SHERWOOD

----------192---- ----------Scout