


KANSAS

Coffey

Section 14 Township 23 Range 13E

Well No. 2 Errett

Company Walker etal

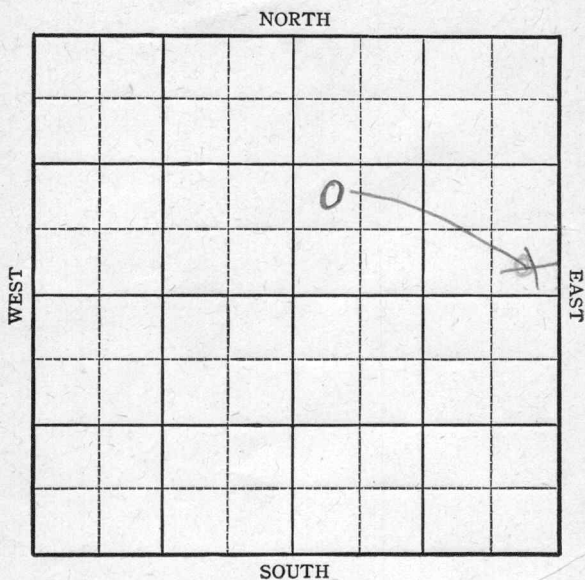

KANSAS

Coffey

Sec. 14 Twp. 23 R. 13-E

Well No. #2 Errett Farm


Walker etal Company

990 Ft. from N. Line

330 Ft. from S. Line

330 Ft. from E. Line

 Ft. from W. Line

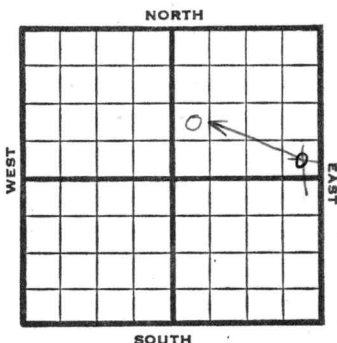

SE NE NW SW NE

1945

REPORT

9/12 Location

9/19

"

9/26

"

10/3

"

10/10

"

10/17

"

10/24

"

10/31

"

11/7

"

11/14

"

11/21

"

11/28

"

12/5

"

12/12

"

12/20

"

12/29

"

1946

1/10

"

1/17

"

1/24

"

1/31

10" - 8'

2/7

Miss 1792' T.D. 1794'

7" - 1790' RUST. 8'

2/14

T.D. 1836' C.O.

2/21

" " "

2/28

" " "

OVER

Miscellaneous

KANSAS Pool Name

Map No. 17 Sec. 14 Twp. 23 R. 13EWell No. 2 Errett

Walker et al.

Company

FIRST REPORT

Contractor

SE NE

SECTION PLAT

			o

Ft. from N. Line

330

Ft. from S. Line

330

Ft. from E. Line

Ft. from W. Line

offset

Coffey

Location X

Rig up

Drilling and Remarks:

RECORD

Cased _____ in., _____ ft.

Sand _____

Gas _____

Oil _____

Total Depth _____

PRODUCTION

1st 24 hrs. Nat. _____

1st 24 hrs. after shot _____

Gas _____ Cu. Ft.

Dry Hole _____

Abandoned _____

Date

SEP 12 1945

19

S. J. LEWIS

Scout

KANSASKansas Pool Name MiscellaneousMap No. 17 Sec. 14 Twp. 23 R. 13EWell No. 2 ErrettWalker et al

Company

CORRECTION

Contractor

NW SW NE

SECTION PLAT

		o	

 Ft. from N. Line990 Ft. from S. Line Ft. from E. Line330 Ft. from W. LineCoffey CountyLocation Rig up

Drilling and Remarks:

reported SE NE

RECORD

Cased in., ft.Sand Gas Oil Total Depth

PRODUCTION

1st 24 hrs. Nat. 1st 24 hrs. after shot Gas Cu. Ft.Dry Hole Abandoned

Date

MAR 6 194619S. J. LEWISScout

KANSAS

Kansas Pool Name MiscellaneousMap No. _____ Sec. 14 Twp. 23 R. 13EWell No. 2 ErrettWalker et al

Company

COMPLETED

Contractor

NW SW NE

SECTION PLAT

		o	

_____ Ft. from N. Line

990 Ft. from S. Line

_____ Ft. from E. Line

330 Ft. from W. LineCoffey County

Location _____

Rig up _____

Drilling and Remarks:

*Miss 1792**7" C 1795**Pump 30.5**35-5*

RECORD

Cased _____ in., _____ ft.

Sand _____

Gas _____

Oil _____

Total Depth 1586

PRODUCTION

1st 24 hrs. Nat. _____

1st 24 hrs. after shot _____

Gas _____ Cu. Ft.

Dry Hole _____

Abandoned _____

Date

MAR 6 1946 19S. J. LEWIS

Scout