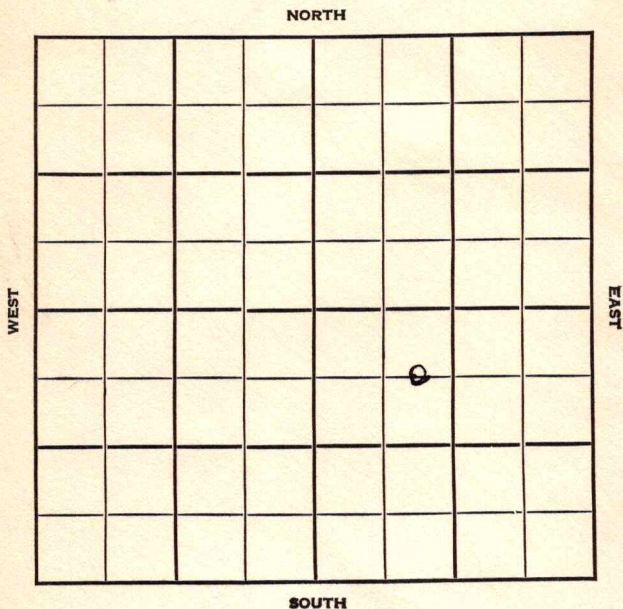


KANSASSection 21 Township 17 Range 4EWell No. #4 Beevan *(Berans)*Company Lauriaux

KANSAS Marion

✓

Sec. 21 Twp. 17 R. 4E

Well No. #4 Beevan Farm

Lauriaux Company

Lost Spring


660 Ft. from N. Line

Ft. from S. Line

Ft. from E. Line

990 Ft. from W. Line

C E L N W S E

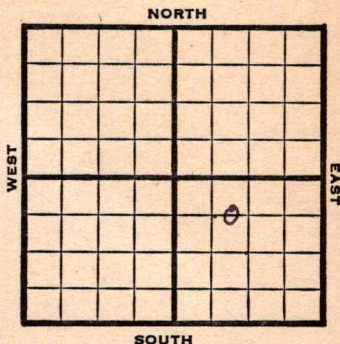

1948 **Elev. 1478'** REPORT

1/21 Machine.

1/26 "

2/4 "

2/11 12" @ 123'

Drlg. 127'

2/18 Drlg 275'

2/25 10" @ 458'

Drlg. 1765'

3/3 SD

3/10 8" @ 1755'

Drlg. 2150'

3/17 **Mississippi 2392-94'**

TD 2394'

5" @ 2394'

RUST

3/24 Drlg. 2460'

3/31 **Mississippi 2392'**

5" @ 2394'

TD 2474'

ABANDONED

Map No. _____ Sec. 21 Twp. 17 R. 4E

Well No. 4 Beevan

Lauriaux Company

FIRST REPORT

Contractor

C E L NW SE

SECTION PLAT

660 Ft. from N. Line

_____ Ft. from S. Line

_____ Ft. from E. Line

990 Ft. from W. Line

		3	

Marion County

Location _____

Rig up _____

Drilling and Remarks:

Machine

RECORD

Cased _____ in., _____ ft.

Sand _____

Gas _____

Oil _____

Total Depth _____

PRODUCTION

1st 24 hrs. Nat. _____

1st 24 hrs. after shot _____

Gas _____ Cu. Ft.

Dry Hole _____

Abandoned _____

Date

JAN 21 1948

19

S. J. LEWIS Scout

Map No. 26 Sec. 21 Twp. 17 R. 4E

Well No. 4 Beevan


Lauriaus Company

ABANDONED

Contractor

C E L NW SE

E. 1478
SECTION PLAT

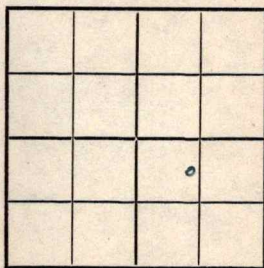

660 Ft. from N. Line

 Ft. from S. Line

 Ft. from E. Line

990 Ft. from W. Line

Marion County

Location

Rig up

Drilling and Remarks:

Miss 2392.
5" C 2394

RECORD

Cased in., ft.

Sand

Gas

Oil

Total Depth 2474

PRODUCTION

1st 24 hrs. Nat.

1st 24 hrs. after shot

Gas Cu. Ft.

Dry Hole

Abandoned

Date

MAR 31 1948 19 S. J. LEWIS Scout