

Butler

KANSAS

SECTION 25 TOWNSHIP 27 RANGE 3 E

WELL NO. #1 Lygriesse (Lygriesse)

COMPANY Ed Adair

NORTH

			0				

WEST

EAST

SOUTH

Butler

KANSAS


SEC. 25	TWP. 27	R. 3E
------------	------------	----------

WELL NO. #1 Lygriessse FARM

COMPANY Ed Adair
CONTRACTOR

Barringer

_____ Ft. from N. Line
 _____ Ft. from S. Line
 _____ Ft. from E. Line
 _____ Ft. from W. Line

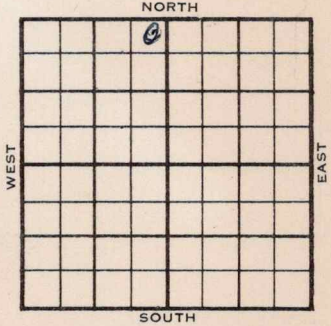

NE NE NW

1956	ELEVATION 1322	REPORT
------	-------------------	--------

1-11 Drlg. surface hole

3-21 Comm. 1-8-56
 8 5/8" @ 125/90
 DST 1948-55 op 1 hr. rec. 18' mud,
 720/20"
 DST 2987-93 op 35 min, rec. 35' mud,
 710/20"
 5 1/2" @ 2989
 DD 3001, 1 boph, frac
 8 boph, 10% wtr.
 P/ 7 boph, 1 bw
 Comp. 25 bopd, 12% wtr.
 L. 1927
 KC 2274
 M. Chert 2756
 K. 2915
 S. sd. 2989
 TD 2993

COMPLETED

County Butler Elev. _____
 Sec. 25 Twp. 27 Rge. 3E
 Company Ed Alair
 Farm Name Lygriesse No. 1

TOPS	DEPTH	LOG	DATUM	Loc. in Sec.												
Anh.				NE NE NW												
TP.																
H.																
Tr.																
Dg.																
Bl.																
L.				Geol. _____												
K.C.				Contr. _____												
B.K.C.																
Ce.																
C.																
M.				Pool												
K.				<u>Barringer</u>												
Mz.				<table border="1"> <tr> <td></td> <td>0</td> <td></td> </tr> <tr> <td colspan="3" style="text-align: center;">JAN 11 58</td> </tr> <tr> <td colspan="3" style="text-align: center;">FIRST REPORT</td> </tr> <tr> <td></td> <td></td> <td></td> </tr> </table>		0		JAN 11 58			FIRST REPORT					
	0															
JAN 11 58																
FIRST REPORT																
Mq.																
V.																
S.																
S.																
A.																
R.																
PE.																
G.																
T.D.																

Date Comm. drlg. surface hole

Co.
Lse.
T. No.
Sec.
T.
R.

County Butler Elev. 1322
 Sec. 25 Twp. 27 Rge. 3E
 Company Ed Adair
 Farm Name Lygriesse No. 1

TOPS	DEPTH	LOG	DATUM
Anh.			
Tp.			
H.			
Tr.			
Dg.			
B.L.			
L.	<u>1927</u>		<u>605</u>
K.C.	<u>2274</u>		<u>952</u>
B.K.C.			
Ce.			
C.			
M. <u>Chart</u>	<u>2756</u>		<u>1434</u>
M.			
K.	<u>2915</u>		<u>1593</u>
Mz.			
Mq.			
V.			
S. <u>SD</u>	<u>2989</u>		<u>1667</u>
S.			
A.			
R.			
Pe.			
G.			
T.D.	<u>2993</u>		

Loc. in Sec. NE NE NW

Geol. _____

Contr. _____

Pool

Barringer

COMPLETE

Date Comm. 1-8-56 MAR 21 1956
8 5/8" @ 125/90 DST 1948-55 open 1 hr.
rec. 18' mud 720/20" DST 2987-93
open 35 min. rec. 35' mud 710/20"
5 1/2" @ 2989 DD 3001 1 boph frac
8 boph 10% wtr. P/ 7 boph 1 bw
Comp. 25 bopd 12% wtr.

Co.

Lse.

No.

Sec.

T.

R.