


Map No. **KANSAS** Sec. **6** Twp. **25** R. **4E**
 Well No. **1- Houston** Farm
El Dorado Ref. Company

NORTH

WEST

EAST

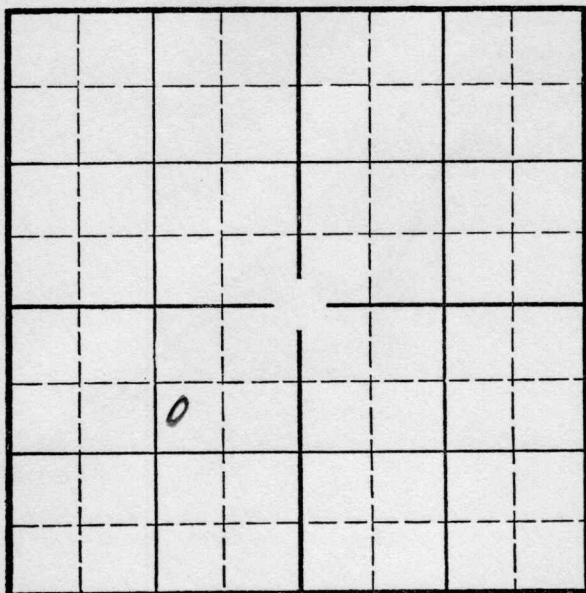

SOUTH

Location
 Drilling Remarks

Rig Up
 Drilling Remarks

RECORD

Cased _____ in. _____ ft.
 Sand _____
 Gas _____
 Oil _____
 Total Depth _____

PRODUCTION

1st 24 hrs. Nat. _____
 1st 24 hrs. after shot _____
 Gas _____ cu. ft. _____
 Dry Hole _____
 Abandoned _____

Butler


Map No. KANSAS Sec. 6 Twp. 25 R. 4E

Well No. 1- Houston Farm

El Dorado Ref.

Company

NORTH

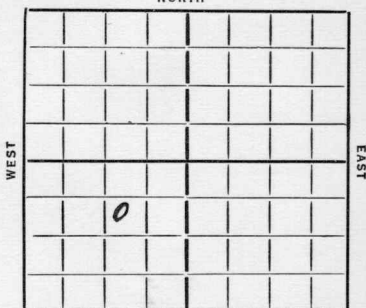

850 Ft. from N. Line

_____ Ft. from S. Line

_____ Ft. from E. Line

1490 Ft. from W. Line

Elev. 1301

SOUTH

Date

REPORT

1985

12/28 Machine

1/2/86 Run

1/10 SD 565 15" 62

1/17 SD 1125

1/24 SD 1410 12" 1189

1/31 " 1900 10" 1695

2/7 8" 2331 WOC

2/14 T Miss 86" 2658

2/21 TD 2667 WOC

2/28 SD 2665 Ann pipe

3/6 150' Oil 2675 TD

1000 acid

3/11 TML 2658

TD 2675

1000 acid

61 Bbls.

COMPLETED

Map No. 14 Sec. 6 Twp. 25 R. 4 E

Well No. 1-Houston

El Dorado Ref Company

Contractor

FIRST REPORTS

SECTION PLAT

	0		

850 Ft. from N. Line

..... Ft. from S. Line

..... Ft. from E. Line

1490 Ft. from W. Line

Location.....

Rig up.....

Drilling and Remarks:

Machine

RECORD

Cased..... in., ft.

Sand.....

Gas.....

Oil.....

Total Depth.....

PRODUCTION

1st 24 hrs. Nat.....

1st 24 hrs. after shot.....

Gas..... Cu. Ft.

Dry Hole.....

Abandoned.....

Date

12-23-35 192..... Scout

ORVAL MANNSCHRECK

KANSAS

Map No. 14 Sec. 6 Twp. 25 R. 4 EWell No. 1- HoustonEl Varado Ref Company

Contractor

COMPLETE

SECTION PLAT

850 Ft. from N. Line

Ft. from S. Line

Ft. from E. Line

1490 Ft. from W. Line

	0		

Location

Rig up

Drilling and Remarks:

1000 and61 bbls

RECORD

Cased _____ in., _____ ft.

Sand TML 2658

Gas _____

Oil _____

Total Depth 2675

PRODUCTION

1st 24 hrs. Nat. _____

1st 24 hrs. after shot _____

Gas _____ Cu. Ft.

Dry Hole _____

Abandoned _____

Date

ORVAL MANNSCHRECK

3-11-36 192 _____ Scout