
Form 51—5M—10-26—Mid-West

KANSAS

Map No. Sec. 22 Twp. 17 R. 4

Well No. 1 Town lot Farm

Max Reynolds Company

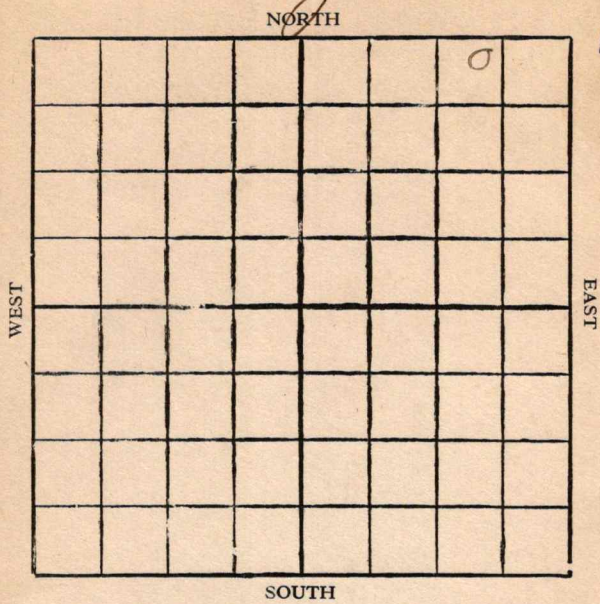


Location

Drilling Remarks

Rig Up

Drilling Remarks

RECORD

Cased in. ft.

Sand

Gas

Oil

Total Depth

PRODUCTION

1st 24 hrs. Nat.

1st 24 hrs. after shot

Gas cu. ft.

Dry Hole

Abandoned


Form 252A—5M—4-27—27425

KANSAS

Map No. ____ Sec. 22 Twp. 17 R 4

Well No. 1 — Town lot Farm

Mac Reynolds Company

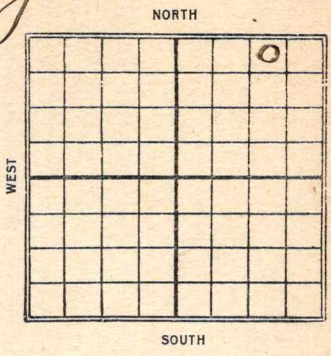


160 Ft. from N. Line

____ Ft. from S. Line

842 Ft. from E. Line

____ Ft. from W. Line

1928

| Date | REPORT |
|---|---|
| 2/1 | Bldg Rig |
| 2/9 | Rigging up- |
| 2/16 | Spudded + S.D. |
| 2/23 | Spudding |
| 3/1 | Spudded + S.D. |
| 3/8 | |
| 3/16 | Drlg 650 |
| 3/22 | " 1360 |
| 3/29 | " 1950 |
| 4/5 | " 2300 |
| 4/12 | Chat 2392 - drlg 2425 1800' oil in hole- |
| 4/19 | 2392-2435 T.D. 2435 200 bbls |

Form 26—1M Bks.—3-23—11959.

NO MAP

Marion

KANSAS

Map No.---------- Sec. 22 Twp. 17 R. 4

Well No. 1 Town lot

Max Reynolds ---------- Company

---------- Contractor

FIRST REPORTS


160 Ft. from N. Line

---------- Ft. from S. Line

847 Ft. from E. Line

---------- Ft. from W. Line

SECTION PLAT

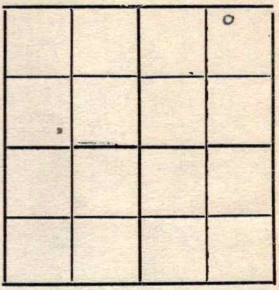

Location ----------

Rig up Blog Rig

Drilling and Remarks:

RECORD

Cased ---------- in., ---------- ft.

Sand ----------

Gas ----------

Oil ----------

Total Depth ----------

PRODUCTION

1st 24 hrs. Nat. ----------

1st 24 hrs. after shot ----------

Gas ---------- Cu. Ft.

Dry Hole ----------

Abandoned ----------

Date

FEB 1 1928

---------- 192---- CHAS. L. SHERWOOD ---------- Scout

Form 26—1M Bks.—3-23—11959.

Marion

no Drawing

Map No. KANSAS Sec. XX Twp. 17 R. 4

Well No. 1 Zinn

Max Reynolds Company

Contractor

COMPLETED


160 Ft. from N. Line

Ft. from S. Line

840 Ft. from E. Line

Ft. from W. Line

SECTION PLAT

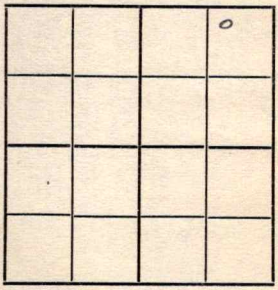

Location

Rig up

Drilling and Remarks:

700 Pb

RECORD

Cased in., ft.

Sand 2397-2435

Gas

Oil

Total Depth 2435

PRODUCTION

1st 24 hrs. Nat.

1st 24 hrs. after shot

Gas Cu. Ft.

Dry Hole

Abandoned

Date

APR 19 1928

192

CHAS. L. SHERWOOD

Scout