


Section 14 Township 23 Range 13 E

Well No. #6 Errett

Company Bill Miller

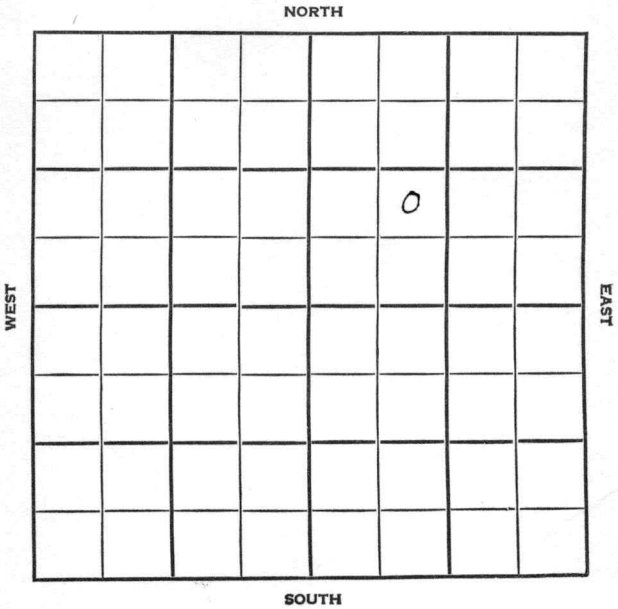

Coffey

KANSAS

SEC.	TWP.	R.
14	23	13E

WELL NO.

#6 Errett

FARM

COMPANY

Bill Miller

CONTRACTOR

Brown


N. Virgil

Ft. from N. Line

Ft. from S. Line

Ft. from E. Line

Ft. from W. Line

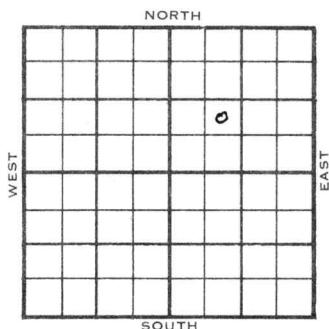

NE SW NE

1955

ELEVATION

REPORT

8/31

Comm 8-29-55
Drlg 100

9/28

Comm 8-29-55
5 1/2" @ 1820
M 1790
TD 1830
CO to 1830 S/3 bo 4 hr frac
Comp 20 bopd

COMPLETED

County Coffey Elev. _____
Sec. 14 Twp. 23 Rge. 13E
Company Bill Miller
Farm Name Errett No. 6

TOPS	DEPTH	LOG	DATUM	Loc. in Sec.
Anh.				NE SW NE
TP.				
H.				
Tr.				
Dg.				
BL.				
L.				Geol.
K.C.				
B.K.C.				Contr.
Ce.				
C.				Brown
M.				
M.				Pool
K.				N. Virgil
Mz.				
Mq.				
V.				
S.				
S.				
A.				
R.				
PE.				
G.				
TD.				

Lse.

No.

Aug 31 '55

FIRST REPORT

Date Comm. 8-29-55
drlg. 100

County Coffey Elev. 13E
 Sec. 14 Twp. 23 Rge. 13E
 Company Bill Miller
 Farm Name Errett No. 6

TOPS	DEPTH	LOG	DATUM	Loc. in Sec.
Anh.				NE SW NE
Tp.				
H.				
Tr.				
Dg.				
BL.				
L.				
K.C.				Geol.
B.K.C.				Contr.
Ce.				Brown
C.				Pool
M.	1790			N. Virgil
M.				
K.				
Mz.				
Ma.				
V.				
S.				
S.				
A.				
R.				
Pe.				
G.				
T.D.	1830			

Date Comm. 8-29-55 SEP 28 1955
5¹/₂" @ 1820 to 1830 S/ 3 bo 4 hr.
 frac Comp. 20 bopd